


Township 13 Range 3W, W.M.
North

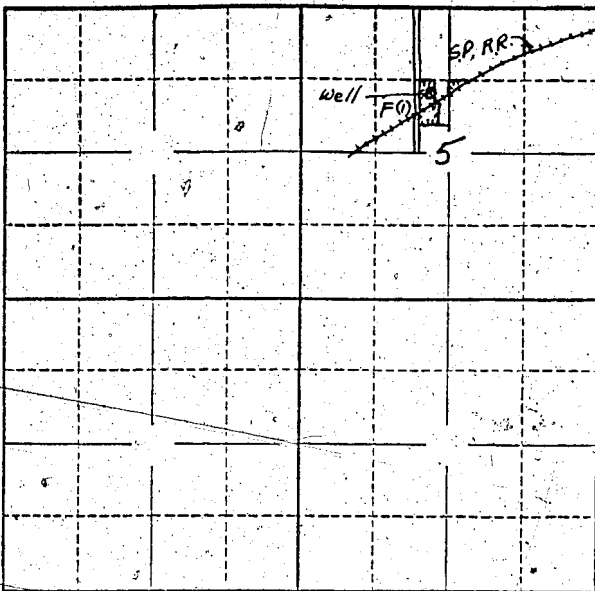

Locate well and acreage of irrigated land on plat.

Scale: 2" = 1-Mile

STATE OF OREGON

County of Washington

} ss.

I, Ely L. West, being first duly sworn, do hereby certify that I have read the foregoing Registration Statement and that all of the items therein contained are true to the best of my knowledge and belief.

Ely L. West
(Signature of Registrant)

Subscribed and sworn to before me this 12 day of August, 1957, 19

My commission expires Dec. 6, 1960

Anna M. Kemp
(Notary Public)

(SEAL)

CERTIFICATE OF REGISTRATION

STATE OF OREGON

County of Marion

} ss.

This is to certify that the foregoing Registration Statement was received in the office of the State Engineer on the 15 day of August, 1957, at 3:00 o'clock M. and has been duly recorded in said office in Book No. 5 of Registration Statements on page 862

Witness my hand this 24 day of April, 1958

Louis A. Dennis
(State Engineer)

By _____

(Deputy)

GR - 862 C