Township 10 S Range 2 W.M.

North

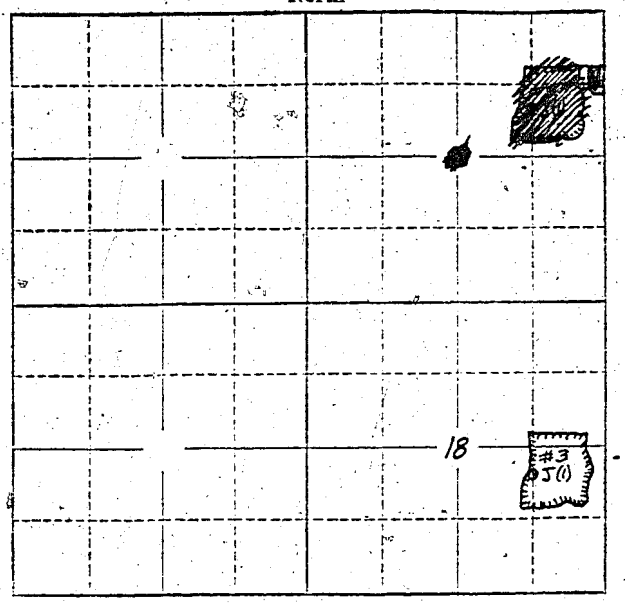

Locate well and acreage of irrigated land on plat.

Scale: 2" = 1 Mile

STATE OF OREGON
County of Linn } ss.

I, Dale and Lillian Eisenmann, being first duly sworn, do hereby certify that I have read the foregoing Registration Statement and that all of the items therein contained are true to the best of my knowledge and belief.

Dale Eisenmann
Lillian Eisenmann
(Signature of Registrant)

Subscribed and sworn to before me this 22nd day of August, 1957.

My commission expires Aug 4, 1961 Saronalee Street
(Notary Public)

(SEAL)

CERTIFICATE OF REGISTRATION

STATE OF OREGON
County of Marion } ss.

This is to certify that the foregoing Registration Statement was received in the office of the State Engineer on the 27th day of August, 1957, at 8:00 o'clock A.M. and has been duly recorded in said office in Book No. 4 of Registration Statements on page GR-564 C

~~Construction should be completed by x-x-x-x-x-x-x-x-x-19x-x-x and the water completely applied to beneficial use by x-x-x-x-x-x-x-x-x-x-19-x-x~~

Witness my hand this 16th day of September, 1957

Lewis A. Stimler
(State Engineer)

$15.00

By
(Deputy)

GR-564 C