Township 6 N Range 35 E, W.M.

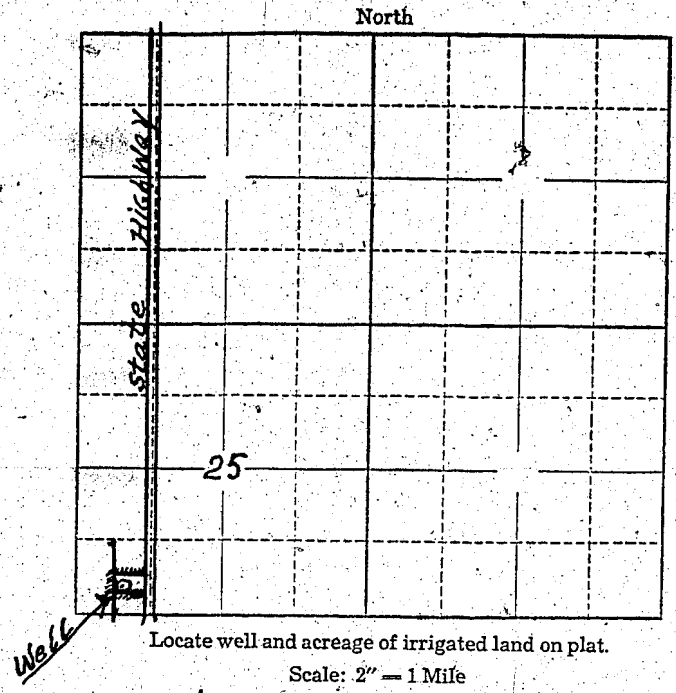

Locate well and acreage of irrigated land on plat.

Scale: 2" = 1 Mile

STATE OF OREGON
County of Umatilla } ss.

I, Henry William Shakelford, being first duly sworn, do hereby certify that I have read the foregoing Registration Statement and that all of the items therein contained are true to the best of my knowledge and belief.

Henry William Shakelford
(Signature of Registrant)

Subscribed and sworn to before me this 6th day of September, 1957.

My commission expires August 19, 1957

(Notary Public)

(SEAL)

CERTIFICATE OF REGISTRATION

STATE OF OREGON
County of Marion } ss.

This is to certify that the foregoing Registration Statement was received in the office of the State Engineer on the 10th day of September, 1957, at 1:00 o'clock P. M. and has been duly recorded in said office in Book No. 4 of Registration Statements on page GR-577 C.

~~Construction shall be completed by x-x-x-x-x-x-x-x-x-x-x-19x-x-x and the water completely applied to beneficial use by x-x-x-x-x-x-x-x-x-x-x-19-x-x-x~~

Witness my hand this 16th day of October, 1957.

Lewis A. Stanley
(State Engineer)

$15.00

By
(Deputy)

GR-577 C