


Township 8S Range 2W W.M.
North

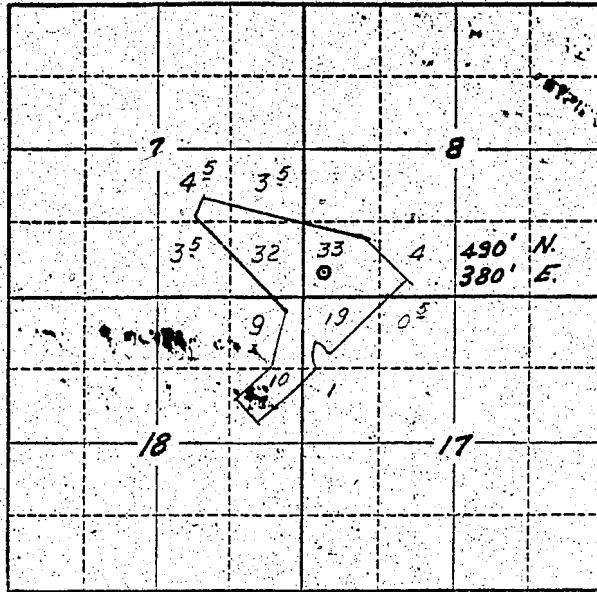

Locate well and acreage of irrigated land on plat.

Scale: 2" = 1 Mile

STATE OF OREGON

County of Marion } ss.

I, E. J. Inland, Secy., Oregon State Board of Control, being first duly sworn, do hereby certify that I have read the foregoing Registration Statement and that all of the items therein contained are true to the best of my knowledge and belief.

E. J. Inland
(Signature of Registrant)

Subscribed and sworn to before me this 8th day of December, 1955

My commission expires July 1, 1957

G. B. ...
(Notary Public)

(SEAL)

CERTIFICATE OF REGISTRATION

STATE OF OREGON

County of Marion } ss.

This is to certify that the foregoing Registration Statement was received in the office of the State Engineer on the 9th day of December, 1955, at 8:00 o'clock A.M. and has been duly recorded in said office in Book No. 1 of Registration Statements on page 53

Construction shall be completed by 9/27/ 1957, and the water ^{will be} completely applied to beneficial use by 9/27/ 1957.

Witness my hand this 24th day of February, 1956.

Lewis A. Stanley
(State Engineer)

By _____ (Deputy)