Township 9 S Range 2 W, W.M.

North

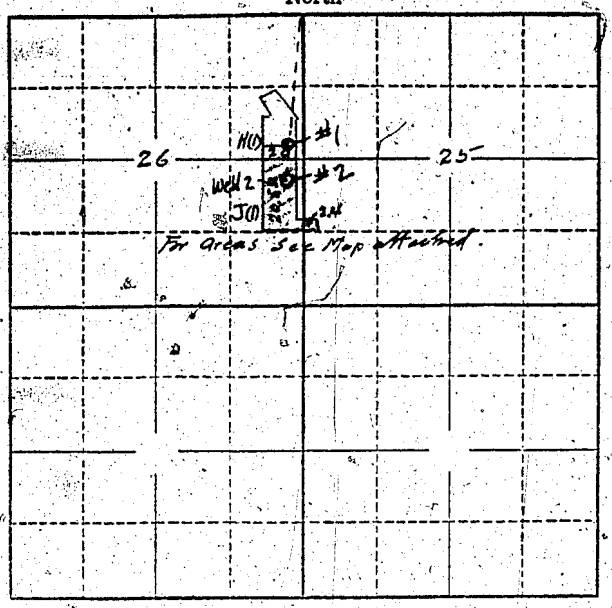

Locate well and acreage of irrigated land on plat.

Scale: 2" = 1 Mile

STATE OF OREGON
County of Marion } ss.

I, Albert Lyons, being first duly sworn, do hereby certify that I have read the foregoing Registration Statement and that all of the items therein contained are true to the best of my knowledge and belief.

Albert Lyons
(Signature of Registrant)

Subscribed and sworn to before me this 9 day of Sept, 19 57

My commission expires 8/21/58

Walter H. Bree
(Notary Public)

(SEAL)

CERTIFICATE OF REGISTRATION

STATE OF OREGON
County of Marion } ss.

This is to certify that the foregoing Registration Statement was received in the office of the State Engineer on the 12th day of September, 19 57, at 8:00 o'clock A. M. and has been duly recorded in said office in Book No. 4 of Registration Statements on page GR-582 C

~~xCgxxtrnetion shall be completed by xxxxxxxxxxxxxxxx 19xxx, and the xwater xcompletely applied xo xxxxxxxxxxxxxxx