


North

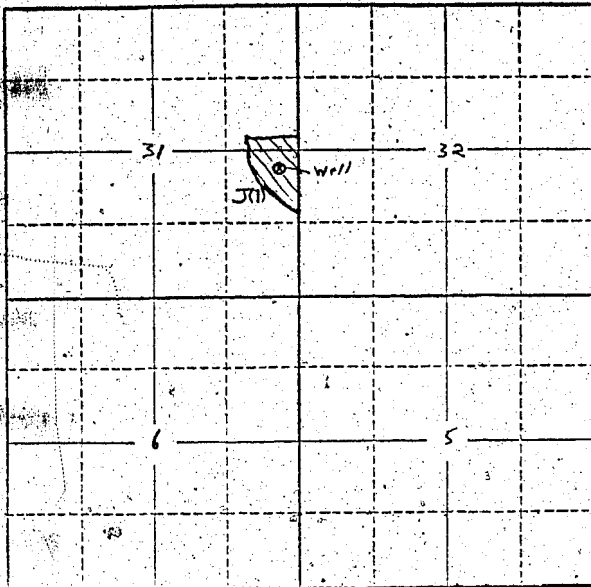

Locate well and acreage of irrigated land on plat.

Scale: 2" = 1 Mile

STATE OF OREGON

County of BENTON } ss:

I, LEIGHTON DAVIS, being first duly sworn, do hereby certify that I have read the foregoing Registration Statement and that all of the items therein contained are true to the best of my knowledge and belief.

Leighton Davis
(Signature of Registrant)

Subscribed and sworn to before me this 20 day of September, 1957

C. W. CARTER

My commission expires My Commission Expires Aug 10, 1961

C. W. Carter
(Notary Public)

(SEAL)

CERTIFICATE OF REGISTRATION

STATE OF OREGON

County of Marion } ss:

This is to certify that the foregoing Registration Statement was received in the office of the State Engineer on the 23rd day of September, 1957, at 8:00 o'clock A. M. and has been duly recorded in said office in Book No. 4 of Registration Statements on page GR-590 C.

~~Construction shall be completed by -x-x-x-x-x-x-x-x-x-x-19-x-x- and the water completely applied to beneficial use by -x-x-x-x-x-x-x-x-x-x-19-x-x-.~~

Witness my hand this 16th day of October, 1957.

Lewis A. Stanley
(State Engineer)

#75cc

By _____ (Deputy)