Township 56 Range 1W, W.M.

North

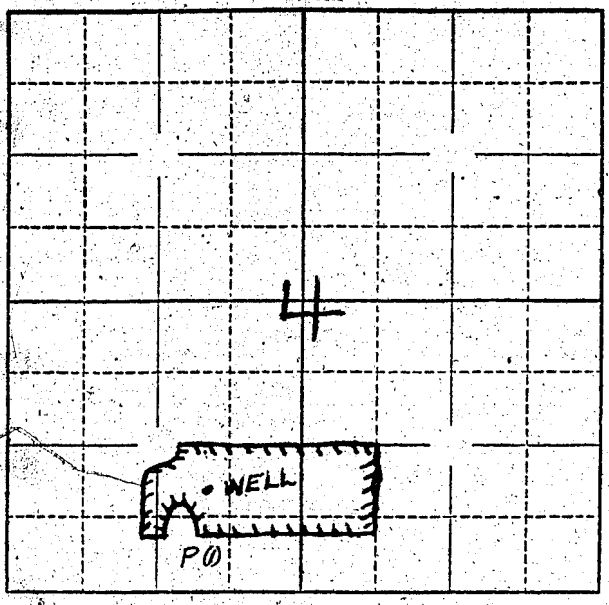

Locate well and acreage of irrigated land on plat.

Scale: 4" = 1 Mile

STATE OF OREGON }
County of Marion } ss.

I, Warren L. Callaway, being first duly sworn, do hereby certify that I have read the foregoing Registration Statement and that all of the items therein contained are true to the best of my knowledge and belief.

Warren L. Callaway
(Signature of Registrant)

Subscribed and sworn to before me this 20 day of September, 19 57

My commission expires June 12, 1958

W. Ethel Duncan
(Notary Public)

(SEAL)

CERTIFICATE OF REGISTRATION

STATE OF OREGON }
County of Marion } ss.

This is to certify that the foregoing Registration Statement was received in the office of the State Engineer on the 23rd day of September, 19 57, at 8:00 o'clock A. M. and has been duly recorded in said office in Book No. 4 of Registration Statements on page GR-591 C.

Witness my hand this 16th day of October, 19 57

Lewis A. Stanley
(State Engineer)

$16.20

By
(Deputy)

GR-591 C