


North

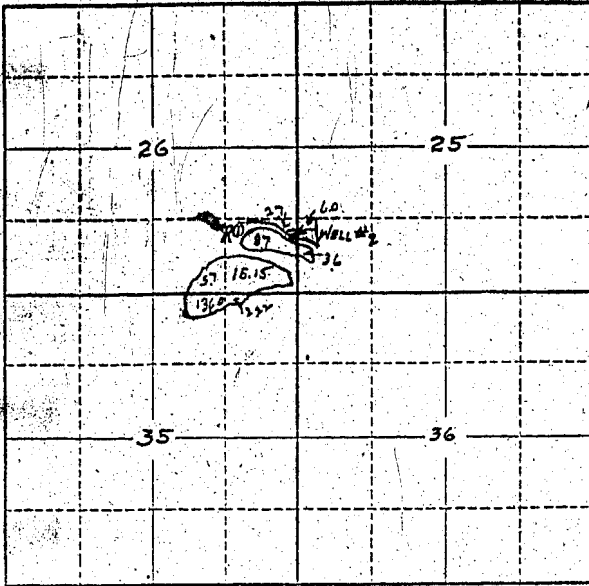

Scale: 2" = 1 Mile

County of _____)

CC Saville
(Signature of Registrant)

My commission expires My Commission Expires March 15, 1938

CERTIFICATE OF REGISTRATION

Witness my hand this 16th day of October, 1957

_____, 19 57
 Lewis A. Stanley
 (State Engineer)

By

(Deputy)

GR-601 C