


Township 9S Range 4W W.M.  
North

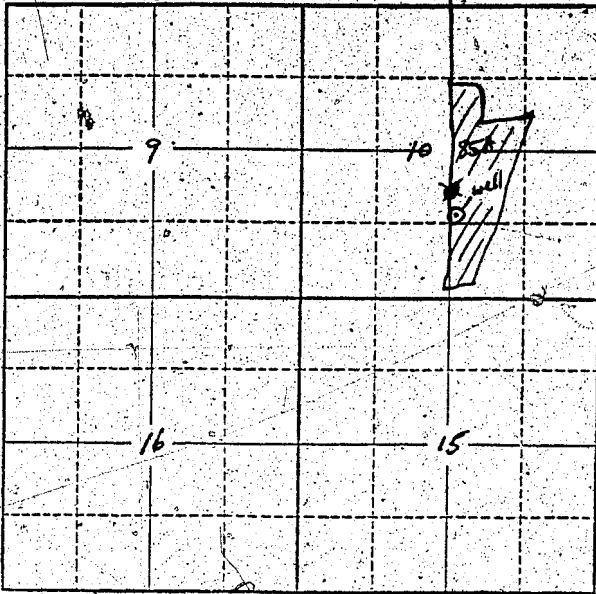

*section 10  
approx 85 acres*

Locate well and acreage of irrigated land on plat.  
Scale: 2" = 1 Mile

STATE OF OREGON

County of Marion ss.

I, Robert J. Pitts, being first duly sworn, do hereby certify that I have read the foregoing Registration Statement and that all of the items therein contained are true to the best of my knowledge and belief.

Robert J. Pitts  
(Signature of Registrant)

Subscribed and sworn to before me this 13th day of December, 1955

My commission expires 7/27/58

Jeanie Baxter  
(Notary Public)

(SEAL)

**CERTIFICATE OF REGISTRATION**

STATE OF OREGON

County of Marion ss.

*For Certificate of Registration see page GR-56 RA*

This is to certify that the foregoing Registration Statement was received in the office of the State Engineer on the 13th day of December, 1955, at 4:30 o'clock P. M. and has been duly recorded in said office in Book No. 1 of Registration Statements on page \_\_\_\_\_


Construction ~~shall be~~ <sup>is</sup> completed by \_\_\_\_\_, 1958, and the water ~~shall be~~ <sup>is</sup> completely applied to beneficial use by July, 1958.

Witness my hand this \_\_\_\_\_ day of \_\_\_\_\_, 19\_\_\_\_

Lewis A. Stanley  
(State Engineer)

By \_\_\_\_\_ (Deputy)

Township 95 Range 41 N, W.M.  
North

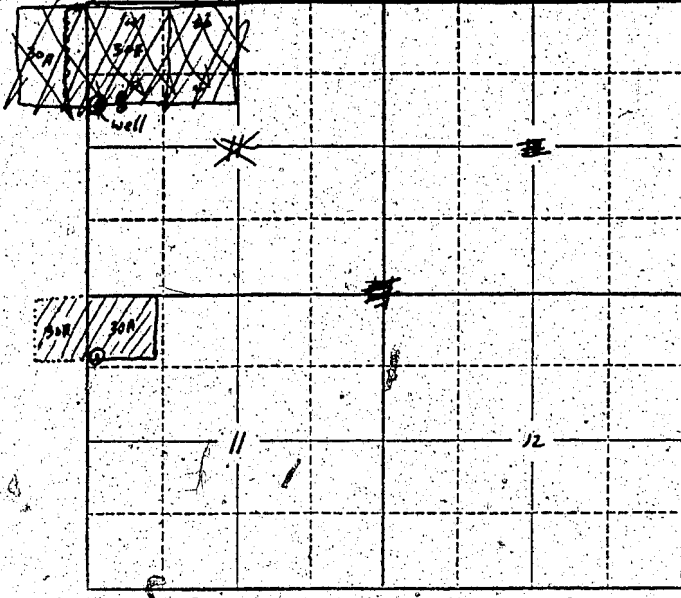

approx. 60 acres  
in northwest  
corner of section 11

Locate well and acreage of irrigated land on plat.  
Scale: 2" = 1 Mile

STATE OF OREGON

County of Marion } ss.

I, Robert J. Pitts, being first duly sworn, do hereby certify that I have read the foregoing Registration Statement and that all of the items therein contained are true to the best of my knowledge and belief.

Robert J. Pitts  
(Signature of Registrant)

Subscribed and sworn to before me this 13<sup>th</sup> day of December, 1955.

My commission expires 9/27/56 Jeanie Baxter  
(Notary Public)

(SEAL)

CERTIFICATE OF REGISTRATION

STATE OF OREGON

County of Marion } ss.

For Certificate of Registration see page GR-56 AA

This is to certify that the foregoing Registration Statement was received in the office of the State Engineer on the 13<sup>th</sup> day of December, 1955, at 4:30 o'clock P. M. and has been duly recorded in said office in Book No. 1 of Registration Statements on page \_\_\_\_\_


Construction <sup>15</sup> shall be completed by \_\_\_\_\_, 19\_\_\_\_, and the water <sup>15</sup> completely applied to beneficial use by \_\_\_\_\_, 19\_\_\_\_.

Witness my hand this \_\_\_\_\_ day of \_\_\_\_\_, 19\_\_\_\_  
Lewis A. Stanley  
(State Engineer)

By \_\_\_\_\_  
(Deputy)

Township 9 S Range 4 W W.M.

North

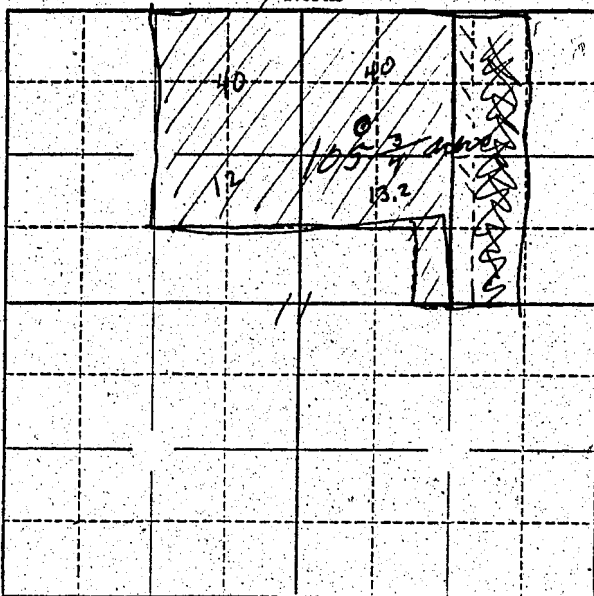

Locate well and acreage of irrigated land on plat.

Scale: 4" = 1 Mile

STATE OF OREGON

County of Marion } ss.

I, Robert J. Fitts, being first duly sworn, do hereby certify that I have read the foregoing Registration Statement and that all of the items therein contained are true to the best of my knowledge and belief.

Robert J. Fitts  
(Signature of Registrant)

Subscribed and sworn to before me this 13th day of December, 1955.

My commission expires 9/27/58

Jeanie Baxter  
(Notary Public)

(SEAL)

CERTIFICATE OF REGISTRATION

STATE OF OREGON

County of Marion } ss.

*For Certificate of Registration see page GR-56 AA*

This is to certify that the foregoing Registration Statement was received in the office of the State Engineer on the 13th day of December, 1955, at 4:30 o'clock P. M. and has been duly recorded in said office in Book No. 1 of Registration Statements on page \_\_\_\_\_

Construction shall be completed by \_\_\_\_\_, 19\_\_\_\_, and the water is completely applied to beneficial use by \_\_\_\_\_, 19\_\_\_\_.

Witness my hand this \_\_\_\_\_ day of \_\_\_\_\_, 19\_\_\_\_


Lewis A. Stanley  
(State Engineer)

By \_\_\_\_\_

(Deputy)

GR-56 K

Township 95 Range 4 W W.M.  
North

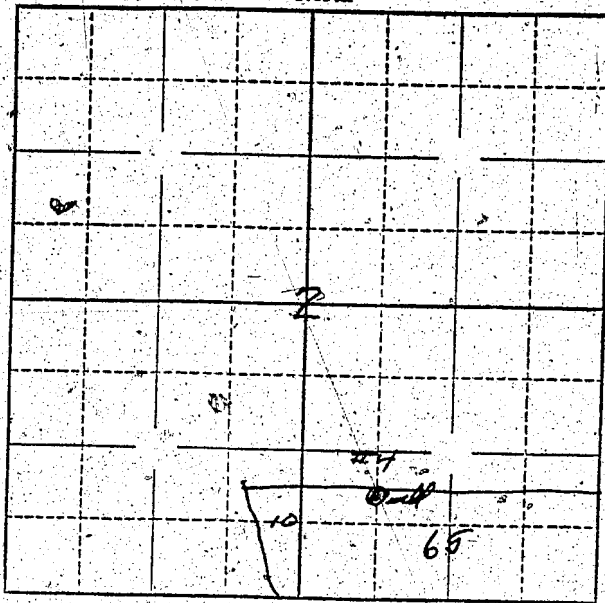

Locate well and acreage of irrigated land on plat.  
Scale: 4' = 1 Mile

STATE OF OREGON

County of Marion } ss.

I, Robert J. Fitts, being first duly sworn, do hereby certify that I have read the foregoing Registration Statement and that all of the items therein contained are true to the best of my knowledge and belief.

Robert J. Fitts  
(Signature of Registrant)

Subscribed and sworn to before me this 13th day of December, 1955.

My commission expires 9/27/58

Jeanie Bayler  
(Notary Public)

(SEAL)

### CERTIFICATE OF REGISTRATION

STATE OF OREGON

County of Marion } ss.

*For Certificate of Registration see page GR-56 AA*

This is to certify that the foregoing Registration Statement was received in the office of the State Engineer on the 13th day of December, 1955, at 4:30 o'clock P. M. and has been duly recorded in said office in Book No. 1 of Registration Statements on page \_\_\_\_\_


Construction shall be completed by 13 \_\_\_\_\_, 1955, and the water 13 completely applied to beneficial use by \_\_\_\_\_, 1955.

Witness my hand this \_\_\_\_\_ day of \_\_\_\_\_, 1955.

Lewis A. Stanley  
(State Engineer)

By \_\_\_\_\_  
(Deputy)

Township 9S Range 4W W.M.  
North

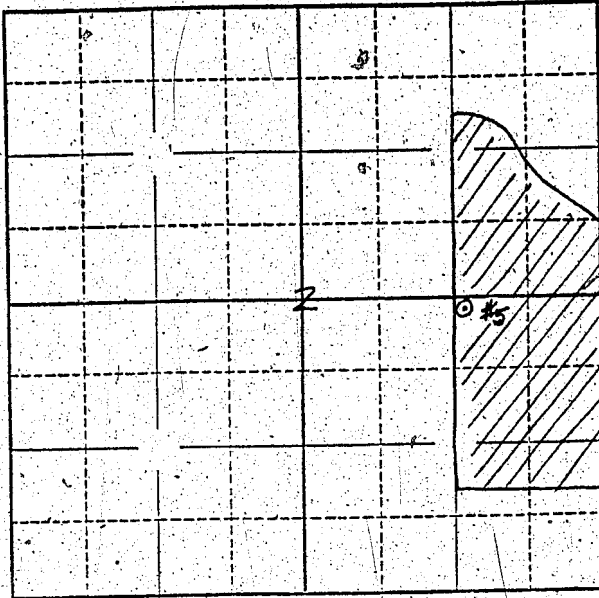

Locate well and acreage of irrigated land on plat.  
Scale: 4" = 1 Mile

STATE OF OREGON }  
County of Marion } ss.

I, Robert J. Pitts, being first duly sworn, do hereby certify that I have read the foregoing Registration Statement and that all of the items therein contained are true to the best of my knowledge and belief.

Robert J. Pitts  
(Signature of Registrant)

Subscribed and sworn to before me this 13<sup>th</sup> day of December, 1955

My commission expires 9/27/58

Jeanie Baxter  
(Notary Public)

(SEAL)

**CERTIFICATE OF REGISTRATION**

STATE OF OREGON }  
County of Marion } ss.

*For Certificate of Registration see page GR- 56 AA*

This is to certify that the foregoing Registration Statement was received in the office of the State Engineer on the 13<sup>th</sup> day of December, 1955, at 4:30 o'clock P. M. and has been duly recorded in said office in Book No. 1 of Registration Statements on page \_\_\_\_\_

Construction shall be completed by 15 \_\_\_\_\_, 1955, and the water completely applied to beneficial use by 15 \_\_\_\_\_, 1955.

Witness my hand this \_\_\_\_\_ day of \_\_\_\_\_, 1955

Lewis J. Stanley  
(State Engineer)

By \_\_\_\_\_ (Deputy)