


4 13

13

23 24

24

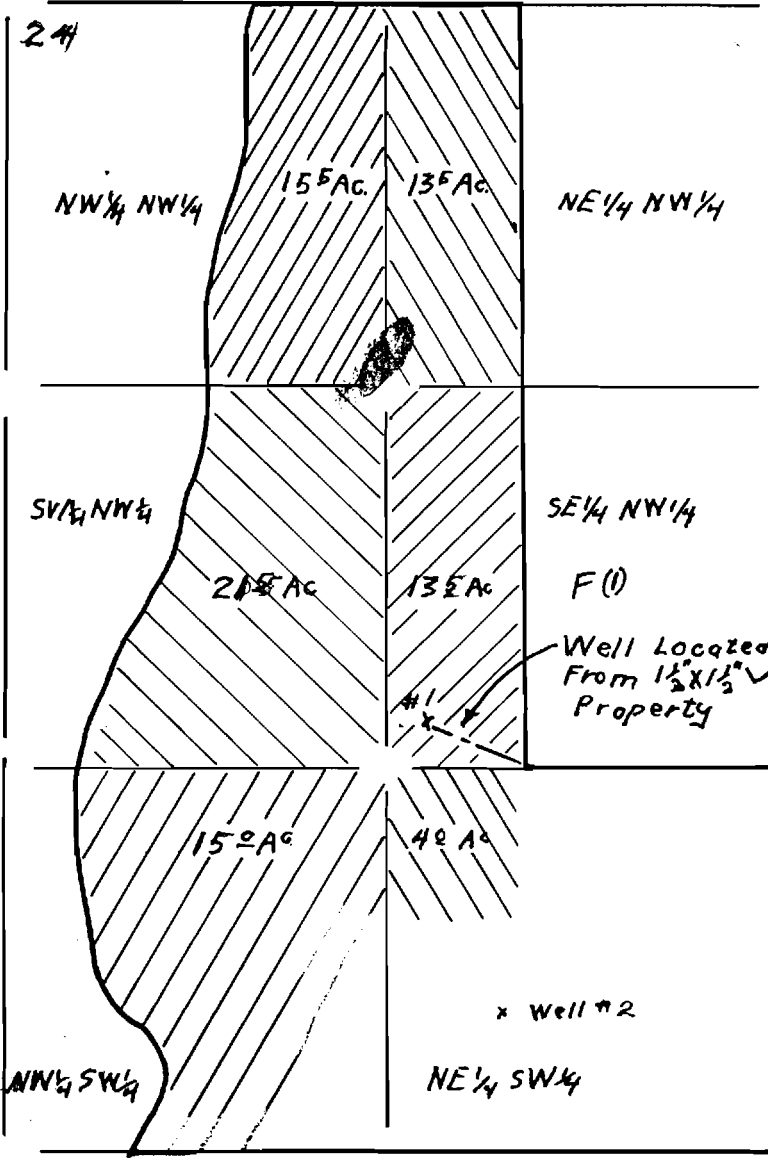

John G. Graham
 Rt 3 Box 555 Corvallis, Oregon
 Sec 24 T13S R 5 W WM
 Scale 1" = 660'

F(1)
 Well Located 381 ft N 65° W
 From 1 1/2 x 1 1/2 iron Marking
 Property Corner

x Well #2

GR-650

23 24

24

26 25

25