


North

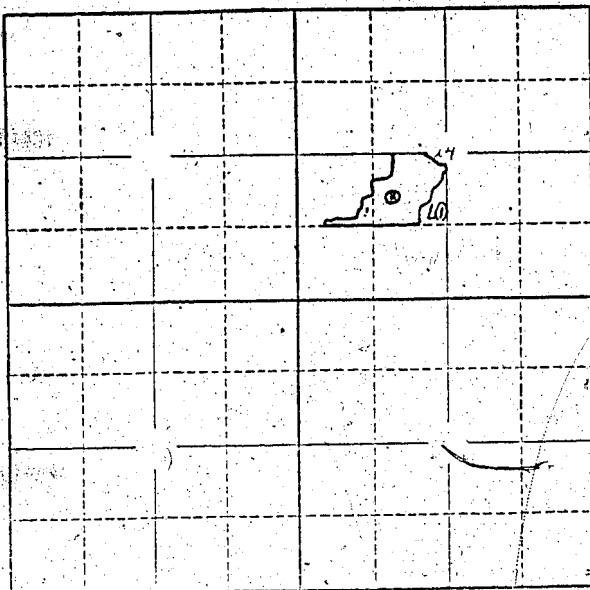

Locate well and acreage of irrigated land on plat.

Scale: 2" = 1 Mile

STATE OF OREGON

County of Benton } ss.

I, John G. Graham, being first duly sworn, do hereby certify that I have read the foregoing Registration Statement and that all of the items therein contained are true to the best of my knowledge and belief.

John G. Graham
(Signature of Registrant)

Subscribed and sworn to before me this 3rd day of October, 1957

My commission expires _____
(Notary Public)

(SEAL)

CERTIFICATE OF REGISTRATION

STATE OF OREGON } ss.
County of Marion

This is to certify that the foregoing Registration Statement was received in the office of the State Engineer on the 7th day of October, 1957, at 10:00 o'clock AM and has been duly recorded in said office in Book No. 4 of Registration Statements on page 62-615 C

Construction shall be completed by ~~XXXXXX~~ 1957 and the water completely applied to beneficial use by ~~XXXXXX~~ 1957

Witness my hand this 16th day of October, 1957.
Lewis A. Struler
(State Engineer)

By _____ (Deputy) GR-615 C