


North

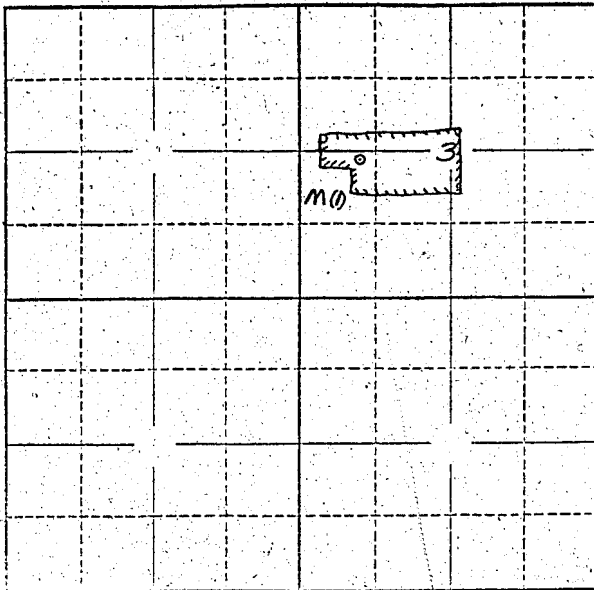

Scale: 2" = 1 Mile

See accompanying map.

County of Multnomah

SS

I, Florence Cleveland Donald, being first duly sworn, do hereby certify that I have read the foregoing Registration Statement and that all of the items therein contained are true to the best of my knowledge and belief.

Frederic Cleveland Board
(Signature of Registrant)

(Signature of Registrant)

Subscribed and sworn to before me this 21st day of May, 1957

My commission expires

(SEAL)

CERTIFICATE OF REGISTRATION

STATE OF OREGON

County of Marion

22

This is to certify that the foregoing Registration Statement was received in the office of the State Engineer on the 7th day of October, 19 57, at 8:00 o'clock A. M. and has been duly recorded in said office in Book No. 4 of Registration Statements on page GR-621 C



Witness my hand this 27th day of November 19 57

LEWIS A. STANLEY

(State Engineer)

By W. J. Rogers

• (Deputy)

GR-621 C