


North

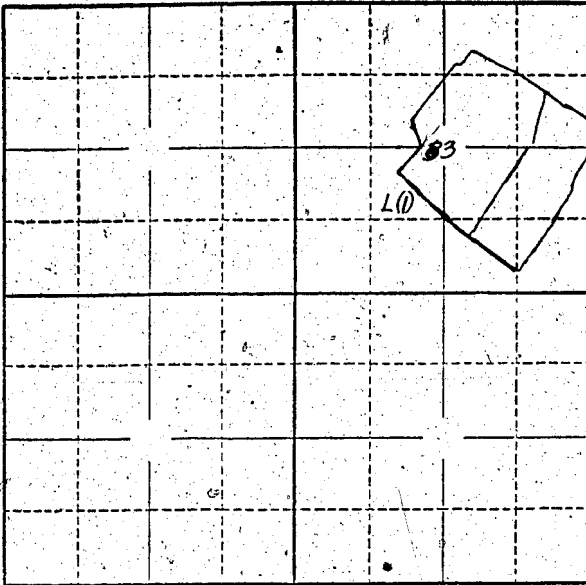

Locate well and acreage of irrigated land on plat.

Scale: 2" = 1 Mile

STATE OF OREGON

County of Waker } ss.

I, Mrs. Lois Coles, being first duly sworn, do hereby certify that I have read the foregoing Registration Statement and that all of the items therein contained are true to the best of my knowledge and belief.

*[Handwritten Signature]*  
(Signature of Registrant)

Subscribed and sworn to before me this 9th day of October, 1957

My commission expires October 3, 1958

*[Handwritten Signature]*  
(Notary Public)

(SEAL)

**CERTIFICATE OF REGISTRATION**

STATE OF OREGON

County of Marion } ss.

This is to certify that the foregoing Registration Statement was received in the office of the State Engineer on the 10th day of October, 1957, at 1:00 o'clock P. M. and has been duly recorded in said office in Book No. 4 of Registration Statements on page GR-653 C.

Witness my hand this 2nd day of January, 1958

*[Handwritten Signature]*  
(State Engineer)

By \_\_\_\_\_ (Deputy)