


Township 175 Range 4 W. W.M.  
North

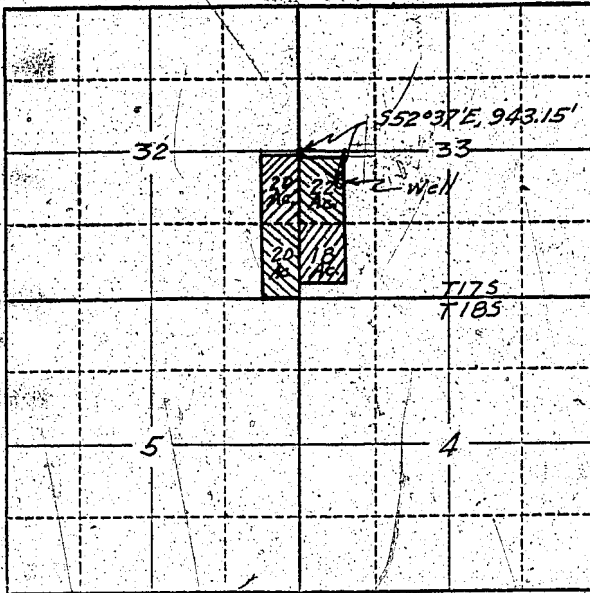

Locate well and acreage of irrigated land on plat.

Scale: 2" = 1 Mile

STATE OF OREGON

County of Multnomah } ss.

I, Gilbert Miner, being first duly sworn, do hereby certify that I have read the foregoing Registration Statement and that all of the items therein contained are true to the best of my knowledge and belief.

Gilbert Miner

(Signature of Registrant)

Subscribed and sworn to before me this 12 day of December, 1955

My commission expires Aug 12, 1957

Maurice N. Ehem

(Notary Public)

(SEAL)

**CERTIFICATE OF REGISTRATION**

STATE OF OREGON

County of Marion } ss.

This is to certify that the foregoing Registration Statement was received in the office of the State Engineer on the 19th day of December, 1955, at 8:00 o'clock P. M. and has been duly recorded in said office in Book No. 1 of Registration Statements on page 57

Construction <sup>is</sup> shall be completed by \_\_\_\_\_, 19\_\_\_\_, and the water <sup>shall be</sup> completely applied to beneficial use by August 3, Oct 1, 1958.

Witness my hand this 24th day of February, 1956.

Lewis A. Stanley

(State Engineer)

By \_\_\_\_\_ (Deputy)