


Township 9S Range 3W, W.M.
North

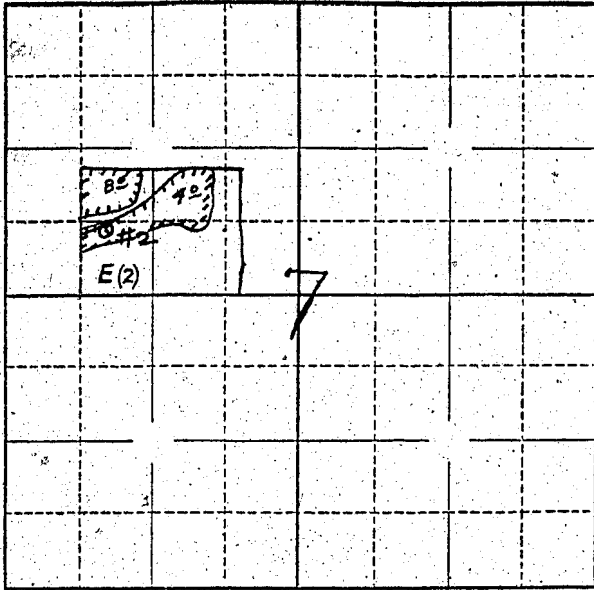

Locate well and acreage of irrigated land on plat.

Scale: ~~8~~ 4" = 1 Mile
4"

STATE OF OREGON

County of Marion } ss.

I, Eldon S. Park, being first duly sworn, do hereby certify that I have read the foregoing Registration Statement and that all of the items therein contained are true to the best of my knowledge and belief.

x Eldon S. Park
(Signature of Registrant)

Subscribed and sworn to before me this 18th day of October, 1957.

My commission expires 9/27/58
Jeanie Baxter
(Notary Public)

(SEAL)

CERTIFICATE OF REGISTRATION

STATE OF OREGON } ss.
County of Marion

This is to certify that the foregoing Registration Statement was received in the office of the State Engineer on the 18th day of October, 1957, at 10:00 o'clock A. M. and has been duly recorded in said office in Book No. 4 of Registration Statements on page GR-640 C.

Witness my hand this 27th day of November, 1957.

\$15.00

LEWIS A. STANLEY
(State Engineer)

By [Signature]
(Deputy)