Township 17S Range 3W, W.M.

North

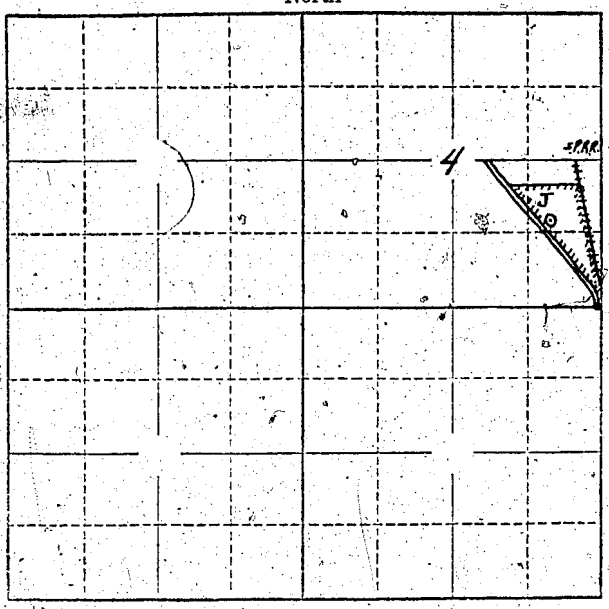

Locate well and acreage of irrigated land on plat.

Scale: 2" = 1 Mile

STATE OF OREGON }
County of Marion } ss.

I, J.O. Crawford, being first duly sworn, do hereby certify that I have read the foregoing Registration Statement and that all of the items therein contained are true to the best of my knowledge and belief.

J.O. Crawford
(Signature of Registrant)

Subscribed and sworn to before me this 22 day of October, 1957.

My commission expires September 9, 1960 Max D. Logan
(Notary Public)

(SEAL)

CERTIFICATE OF REGISTRATION

STATE OF OREGON }
County of Marion } ss.

This is to certify that the foregoing Registration Statement was received in the office of the State Engineer on the 22nd day of October, 19 57, at 8:00 o'clock A. M. and has been duly recorded in said office in Book No. 4 of Registration Statements on page GR-642.

~~Construction shall be completed by x-x-x-x-x-x-x-x-x-19xx and the water completely applied to beneficial use by x-x-x-x-x-x-x-x-x-19-x-x~~

Witness my hand this 27th day of November, 19 57

$15.00

LEWIS A. STANLEY
(State Engineer)

By Max D. Logan
(Deputy)

GR-642 C