


Township 5S Range 3W, W.M.
North

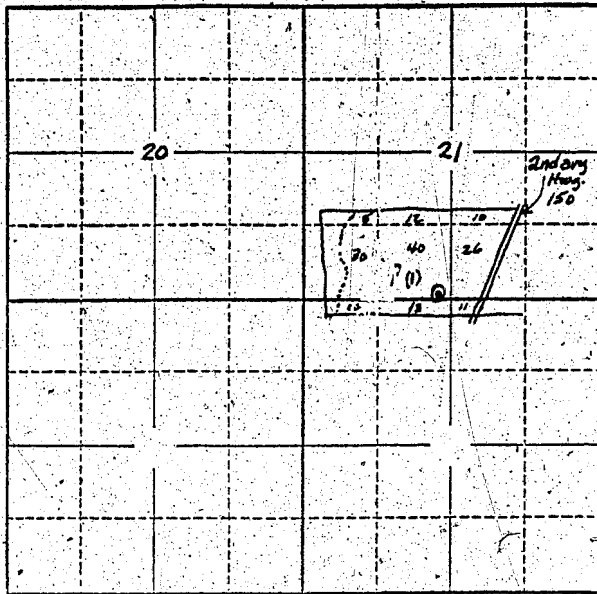

Locate well and acreage of irrigated land on plat.
Scale: 2" = 1 Mile

STATE OF OREGON

County of Yamhill

ss.

I, Fred C. Stockhoff being first duly sworn, do hereby certify that I have read the foregoing Registration Statement and that all of the items therein contained are true to the best of my knowledge and belief.

Fred C. Stockhoff
(Signature of Registrant)

Subscribed and sworn to before me this 15th day of December, 1955

My commission expires February 10, 1956

Frank Chamber
(Notary Public)

(SEAL)

CERTIFICATE OF REGISTRATION

STATE OF OREGON

County of Marion

ss.

This is to certify that the foregoing Registration Statement was received in the office of the State Engineer on the 21st day of December, 1955, at 10:20 o'clock A. M. and has been duly recorded in said office in Book No. 1 of Registration Statements on page 5B

Construction shall be completed by _____, 19____, and the water ^{is} completely applied to beneficial use by _____, 19____

Witness my hand this 24th day of February, 1956

Laura A. Stanley
(State Engineer)

By _____

(Deputy)

GR-58 C