


North

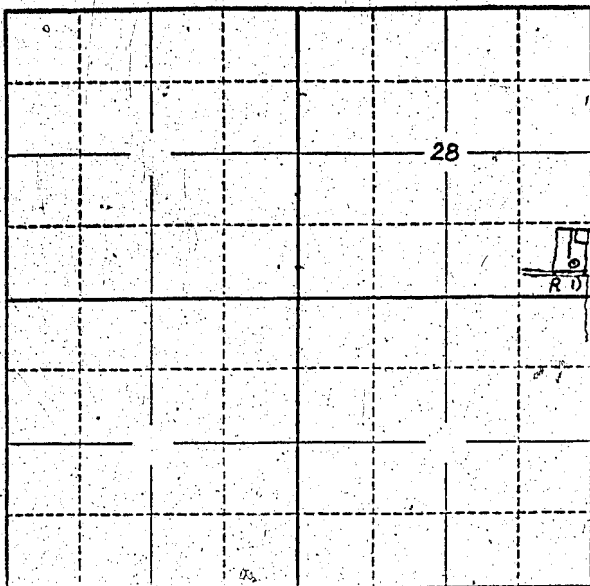

Locate well and acreage of irrigated land on plat.

Scale: 2" = 1 Mile

STATE OF OREGON

County of Lane } ss.

I, Wilfred H. Cook, being first duly sworn, do hereby certify that I have read the foregoing Registration Statement and that all of the items therein contained are true to the best of my knowledge and belief.

Wilfred H. Cook
(Signature of Registrant)

Subscribed and sworn to before me this 26 day of Oct, 1957

John A. Christ
(Notary Public)

My commission expires May 9, 1960

(SEAL)

CERTIFICATE OF REGISTRATION

STATE OF OREGON }
County of Marion } ss.

This is to certify that the foregoing Registration Statement was received in the office of the State Engineer on the 28th day of October, 1957, at 8:00 o'clock A. M. and has been duly recorded in said office in Book No. 4 of Registration Statements on page GR-718 C.

Witness my hand this 24th day of January, 1958

Lewis A. Stanley
(State Engineer)

By _____ (Deputy)