


Township 8.5 Range 2W, W.M.

North

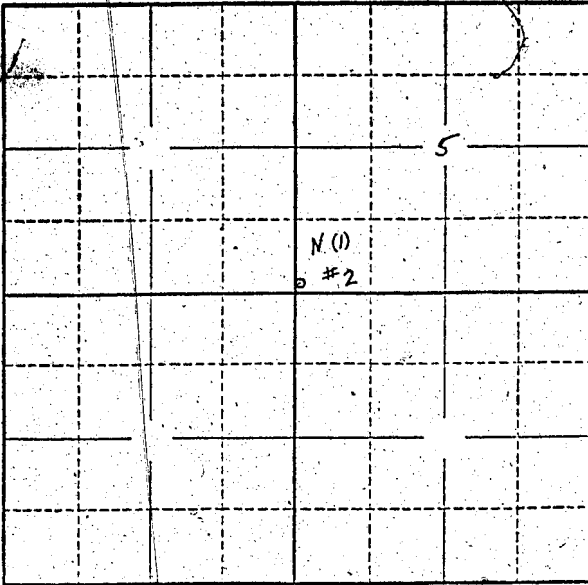

Locate well and acreage of irrigated land on plat.

Scale: 2" = 1 Mile

STATE OF OREGON

County of Marion

} ss.

I, D. K. Brooks, M. D., being first duly sworn, do hereby certify that I have read the foregoing Registration Statement and that all of the items therein contained are true to the best of my knowledge and belief.

*D. K. Brooks*  
.....  
(Signature of Registrant)

Subscribed and sworn to before me this 18th day of October, 1957, 19   

My commission expires ~~Sept. 23, 1960~~

*Charlie E. Keeling*  
.....  
(Notary Public)

(SEAL)

**CERTIFICATE OF REGISTRATION**

STATE OF OREGON

County of Marion

} ss.

This is to certify that the foregoing Registration Statement, was received in the office of the State Engineer on the 16th day of December, 1957, at 8:00 o'clock A. M. and has been duly recorded in said office in Book No. 4 of Registration Statements on page GR-690 C

Witness my hand this 24th day of January

*Lewis A. Stanley*  
.....  
(State Engineer)

By \_\_\_\_\_  
(Deputy)