


Township 8S Range 2W W.M.

North

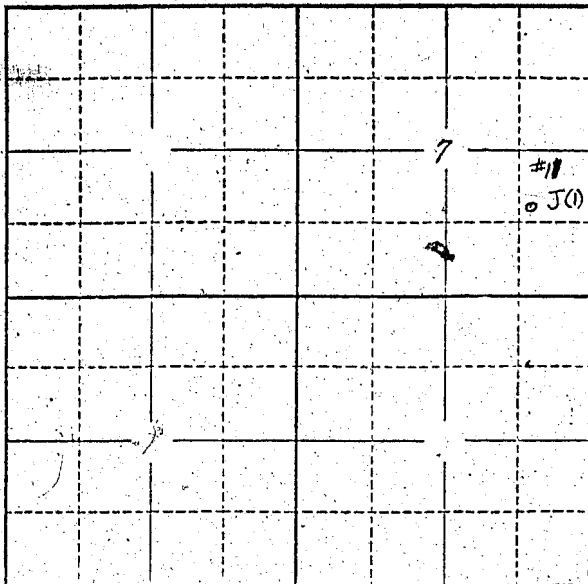

Locate well and acreage of irrigated land on plat.

Scale: 2" = 1 Mile

STATE OF OREGON

County of Marion

} ss.

I, D. K. Brooks, M. D., being first duly sworn, do hereby certify that I have read the foregoing Registration Statement and that all of the items therein contained are true to the best of my knowledge and belief.

D. K. Brooks

(Signature of Registrant)

Subscribed and sworn to before me this 18 day of October, 1957

My commission expires Sept 23, 1960

Pauline E. Keating

(Notary Public)

(SEAL)

CERTIFICATE OF REGISTRATION

STATE OF OREGON

County of Marion

} ss.

This is to certify that the foregoing Registration Statement was received in the office of the State Engineer on the 16th day of December, 1957, at 8:00 o'clock 4 M. and has been duly recorded in said office in Book No. 4 of Registration Statements on page 66-691 C

Witness my hand this 24th day of January, 1958

Lewis A. Stanley

(State Engineer)

By

(Deputy)

GR - 691 C