


Township 6S Range 1E W.M.
North

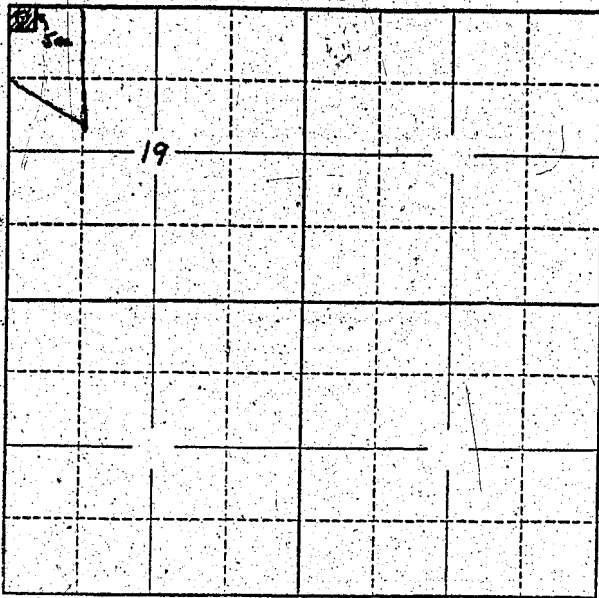

Locate well and acreage of irrigated land on plat.
Scale: 2" = 1 Mile

STATE OF OREGON }
County of Marion } ss.

I, Ben Fisher, being first duly sworn, do hereby certify that I have read the foregoing Registration Statement and that all of the items therein contained are true to the best of my knowledge and belief.

Ben Fisher
(Signature of Registrant)

Subscribed and sworn to before me this 19 day of January, 1956

My commission expires Dec. 20, 1957 Elizabeth Swanson
(Notary Public)

(SEAL)

CERTIFICATE OF REGISTRATION

STATE OF OREGON }
County of Marion } ss.

This is to certify that the foregoing Registration Statement was received in the office of the State Engineer on the 10th day of January, 1956, at 10:00 o'clock A. M. and has been duly recorded in said office in Book No. 1 of Registration Statements on page 61

Construction shall be completed by _____, 1956, and the water ^{is} completely applied to beneficial use by _____, 1956.

Witness my hand this 29th day of February, 1956
Leona A. Stanley
(State Engineer)

By _____
(Deputy)