


Township 115 Range 44, W.M.
North

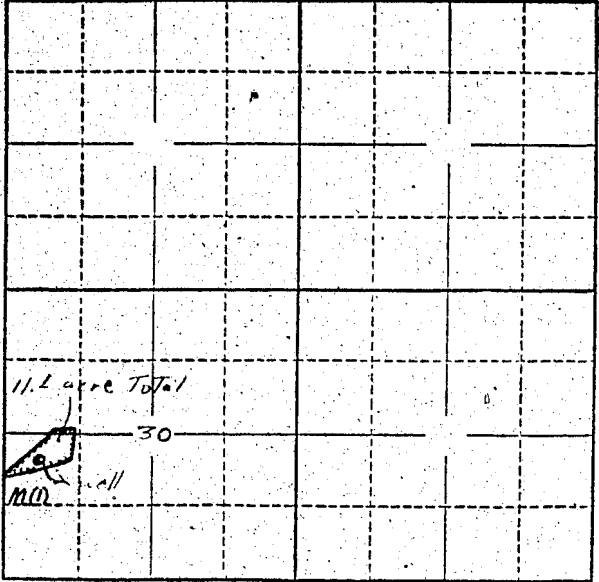

Locate well and acreage of irrigated land on plat.
Scale: 2" = 1 Mile

STATE OF OREGON }
County of BENTON } ss.

I, CLYDE S. MILLSAP, being first duly sworn, do hereby certify that I have read the foregoing Registration Statement and that all of the items therein contained are true to the best of my knowledge and belief.

Clyde S. Millsap
(Signature of Registrant)

Subscribed and sworn to before me this 6th day of November, 1957.

NOTARY PUBLIC FOR OREGON
My commission expires March 29, 1960

Anne D. Bauer
(Notary Public)

(SEAL)

CERTIFICATE OF REGISTRATION

STATE OF OREGON }
County of Marion } ss.

This is to certify that the foregoing Registration Statement was received in the office of the State Engineer on the 15th day of November, 1957, at 1:00 o'clock P.M. and has been duly recorded in said office in Book No. 4 of Registration Statements on page GR-691 C.

Witness my hand this 21st day of January

1958
Lewis A. Stanley
(State Engineer)

By _____
(Deputy)