


North

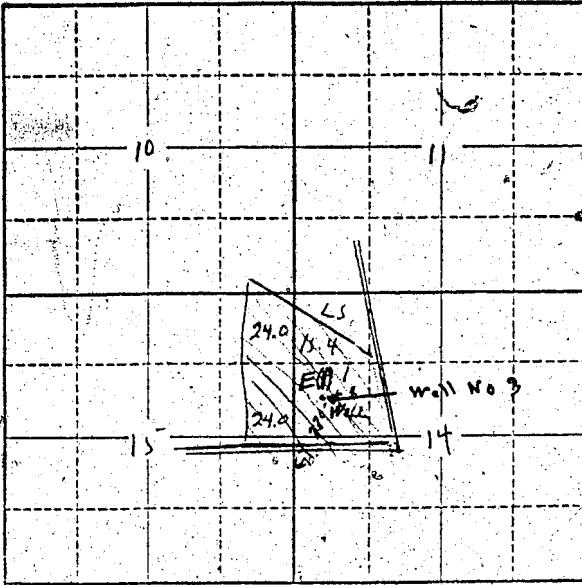

Locate well and acreage of irrigated land on plat.

Scale: 2" = 1 Mile

STATE OF OREGON

County of Marion } ss.

I, Jack R. Chapin, being first duly sworn, do hereby certify that I have read the foregoing Registration Statement and that all of the items therein contained are true to the best of my knowledge and belief.

Signature of Registrant: Jack R. Chapin

Subscribed and sworn to before me this 15th day of November, 1957.

My commission expires June 17th 1961

Notary Public: Wm. S. Bartholomew

(SEAL)

CERTIFICATE OF REGISTRATION

STATE OF OREGON } ss. County of Marion

This is to certify that the foregoing Registration Statement was received in the office of the State Engineer on the 15th day of November, 1957, at 10:00 o'clock A.M. and has been duly recorded in said office in Book No. 4 of Registration Statements on page GR-669 C

Construction shall be completed by 1-1-58 and the water completely applied to beneficial use by 1-1-58

Witness my hand this 2nd day of January, 1958.

Signature of State Engineer: Lewis A. Stanley

(State Engineer)

By (Deputy)

GR-669C

Handwritten number: 25