


North

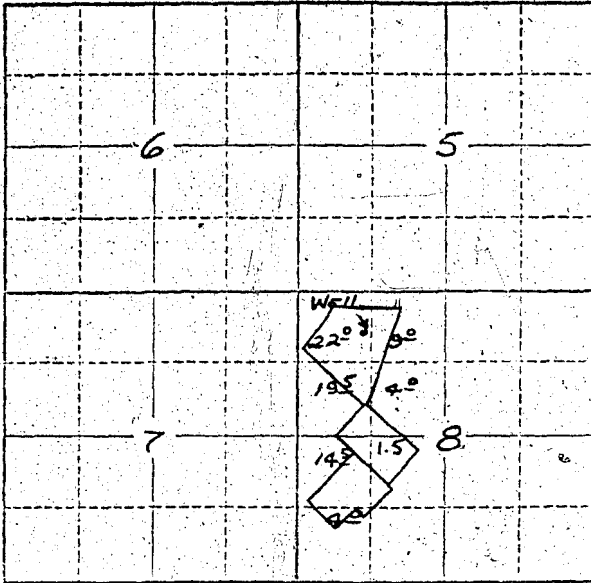

Locate well and acreage of irrigated land on plat.

Scale: 2" = 1 Mile

STATE OF OREGON

County of _____ } ss.

I, Rudolph Bartholomew being first duly sworn, do hereby certify that I have read the foregoing Registration Statement and that all of the items therein contained are true to the best of my knowledge and belief.

Rudolph Bartholomew
(Signature of Registrant)

Subscribed and sworn to before me this 18th day of November, 1957.

My commission expires June 12th 1961 Wm. S. Bartholomew
(Notary Public)

(SEAL)

CERTIFICATE OF REGISTRATION

STATE OF OREGON

County of Marion } ss.

This is to certify that the foregoing Registration Statement was received in the office of the State Engineer on the 18th day of November, 1957, at 8:00 o'clock A. M. and has been duly recorded in said office in Book No. 4 of Registration Statements on page GR-699 C.

~~Construction shall be completed by _____ 19____ and the water completely applied to beneficial use by _____ 19____~~

Witness my hand this 24th day of January, 1958

Lewis A. Struley
(State Engineer)

By _____ (Deputy)

GR-699 C

24.75