


Section 1,

Township 1 S Range 1 W, W.M.  
North

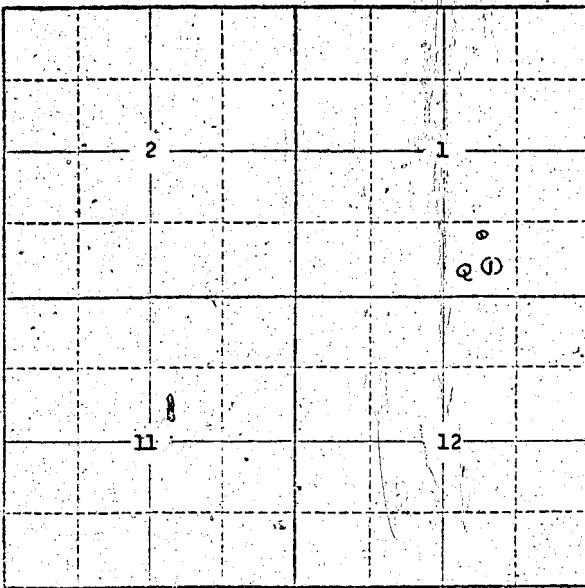

See map prepared in connection with application shown at Item 15. (Attached)

Locate well and acreage of irrigated land on plat.

Scale: 2" = 1 Mile

STATE OF OREGON

County of Multnomah } ss.

I, Wade Strowger being first duly sworn, do hereby certify that I have read the foregoing Registration Statement and that all of the items therein contained are true to the best of my knowledge and belief.

SUNSET HILLS MEMORIAL PARK  
By [Signature] (Signature of Registrant)

Subscribed and sworn to before me this 18th day of November, 1957

My commission expires Dec. 11, 1959 [Signature] (Notary Public)

(SEAL)

CERTIFICATE OF REGISTRATION

STATE OF OREGON } ss.  
County of Marion

This is to certify that the foregoing Registration Statement was received in the office of the State Engineer on the 19th day of November, 1957, at 8:00 o'clock A.M. and has been duly recorded in said office in Book No. 4 of Registration Statements on page GR-701 C.

~~Construction shall be completed by X-X-X-X-X-X-X-X-X-X-X-X and the water completely applied to beneficial use by X-X-X-X-X-X-X-X-X-X-X-X~~

Witness my hand this 24th day of January, 1958 [Signature] (State Engineer)

By [Signature] (Deputy) GR-701 C