


North

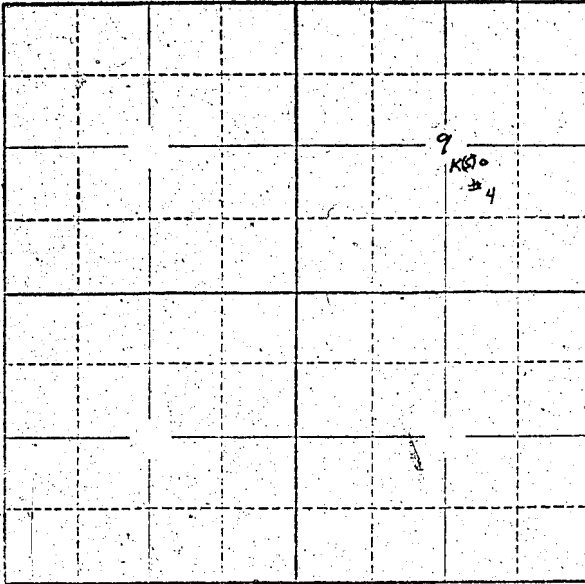

Locate well and acreage of irrigated land on plat.

Scale: 2" = 1 Mile

STATE OF OREGON

County of Marion } ss.

I, F. H. Huber, being first duly sworn, do hereby certify that I have read the foregoing Registration Statement and that all of the items therein contained are true to the best of my knowledge and belief.

[Signature]
 (Signature of Registrant)

Subscribed and sworn to before me this 14th day of November, 1957.

My commission expires January 15, 1960 *[Signature]*
 (Notary Public)

(SEAL)

CERTIFICATE OF REGISTRATION

STATE OF OREGON } ss.
 County of Marion

This is to certify that the foregoing Registration Statement was received in the office of the State Engineer on the 21st day of November, 1957, at 8:00 o'clock A. M. and has been duly recorded in said office in Book No. 4 of Registration Statements on page GR-711 C.

Construction shall be completed by xxxxxx 19xx and the water completely applied to beneficial use by xxxxxx 19xx.

Witness my hand this 21st day of January, 1958.

[Signature]
 (State Engineer)

By _____
 (Deputy)

GR-711 C