


Township 4 N Range 1 W, W.M.
North.

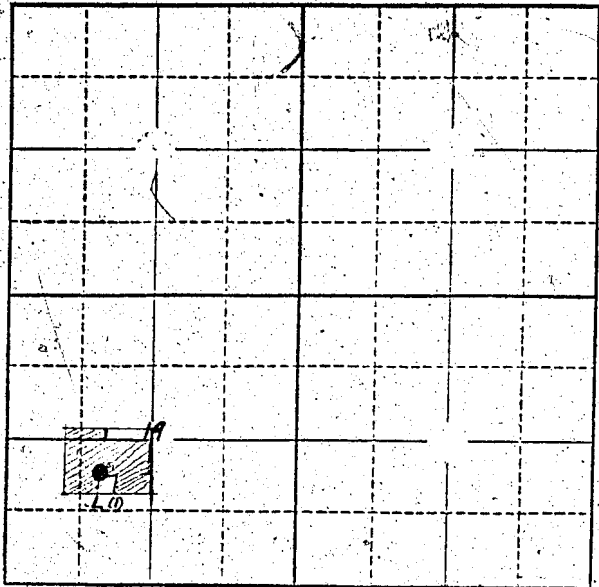

Locate well and acreage of irrigated land on plat.
Scale: 2" = 1 Mile

STATE OF OREGON

County of Columbia } ss.

I, Philip L. Kirby, being first duly sworn, do hereby certify that I have read the foregoing Registration Statement and that all of the items therein contained are true to the best of my knowledge and belief.

Philip L. Kirby
(Signature of Registrant)

Subscribed and sworn to before me this 22nd day of November, 1957.

My commission expires _____
Caroleen D. Martini
(Notary Public)

(SEAL)

NOTARY PUBLIC, OREGON
Commission Expires July 24, 1958

CERTIFICATE OF REGISTRATION

STATE OF OREGON } ss.
County of Marion

This is to certify that the foregoing Registration Statement was received in the office of the State Engineer on the 26th day of November, 1957, at 9:00 o'clock A.M. and has been duly recorded in said office in Book No. 4 of Registration Statements on page 6B-717 C.

Witness my hand this 24th day of January, 1958

Lewis A. Stanley
(State Engineer)

By _____
(Deputy)