


Township 18 S Range 3 W, W.M.
North

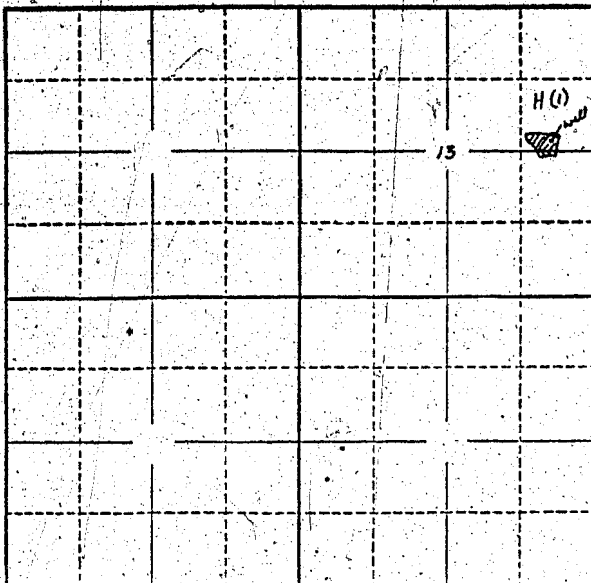

Locate well and acreage of irrigated land on plat.

Scale: 2" = 1 Mile

STATE OF OREGON

County of Lane } ss.

I, _____, being first duly sworn, do hereby certify that I have read the foregoing Registration Statement and that all of the items therein contained are true to the best of my knowledge and belief.

Floyd A. McBe
(Signature of Registrant)

Subscribed and sworn to before me this 25th day of Nov, 1957

My commission expires Aug 31, 1958 Harry S. Walker
(Notary Public)

(SEAL)

CERTIFICATE OF REGISTRATION

STATE OF OREGON }
County of Marion } ss.

This is to certify that the foregoing Registration Statement was received in the office of the State Engineer on the 27th day of November, 1957, at 5:00 o'clock A. M. and has been duly recorded in said office in Book No. 4 of Registration Statements on page GR-722 C.

Witness my hand this 24th day of January, 1958
Lewis A. Stanley
(State Engineer)

By _____
(Deputy)