


North

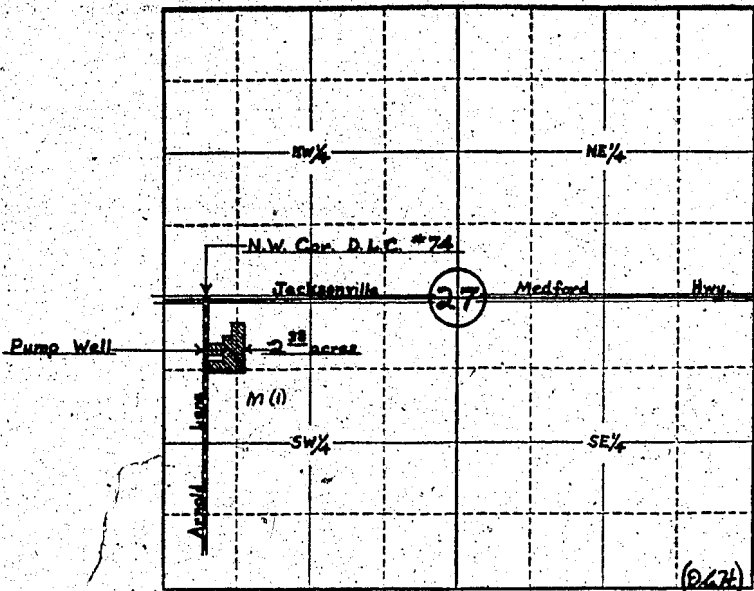

Locate well and acreage of irrigated land on plat.

Scale: 4" = 1 Mile

STATE OF OREGON

County of JACKSON

ss.

WE

O. D. DAY and VERGIA DAY

being first duly sworn, do hereby certify that I have read the foregoing Registration Statement and that all of the items therein contained are true to the best of my knowledge and belief.

O. D. Day
Vergia Day

(Signature of Registrant)

Subscribed and sworn to before me this 26th day of November, 19 57

My commission expires Mar. 8, 1958

Carl Martin

(Notary Public)

(SEAL)

CERTIFICATE OF REGISTRATION

STATE OF OREGON

County of Marion

ss.

This is to certify that the foregoing Registration Statement was received in the office of the State Engineer on the 27th day of November, 1957, at 1:00 o'clock P. M. and has been duly recorded in said office in Book No. 4 of Registration Statements on page GR-723 C

Witness my hand this 21th day of January, 19 58

Laura A. Stanley

(State Engineer)

By

(Deputy)

GR-723 C

\$15.00