


# Groundwater Registration Modification Map GR-756 Existing Place of Use

Located in the NE 1/4 of the NW 1/4 Section 2, NE 1/4 of the NE 1/4 of Section 3, and the SW 1/4 of the NE 1/4 of Section 3 all being in Township 37 South, Range 2 West, W.M.

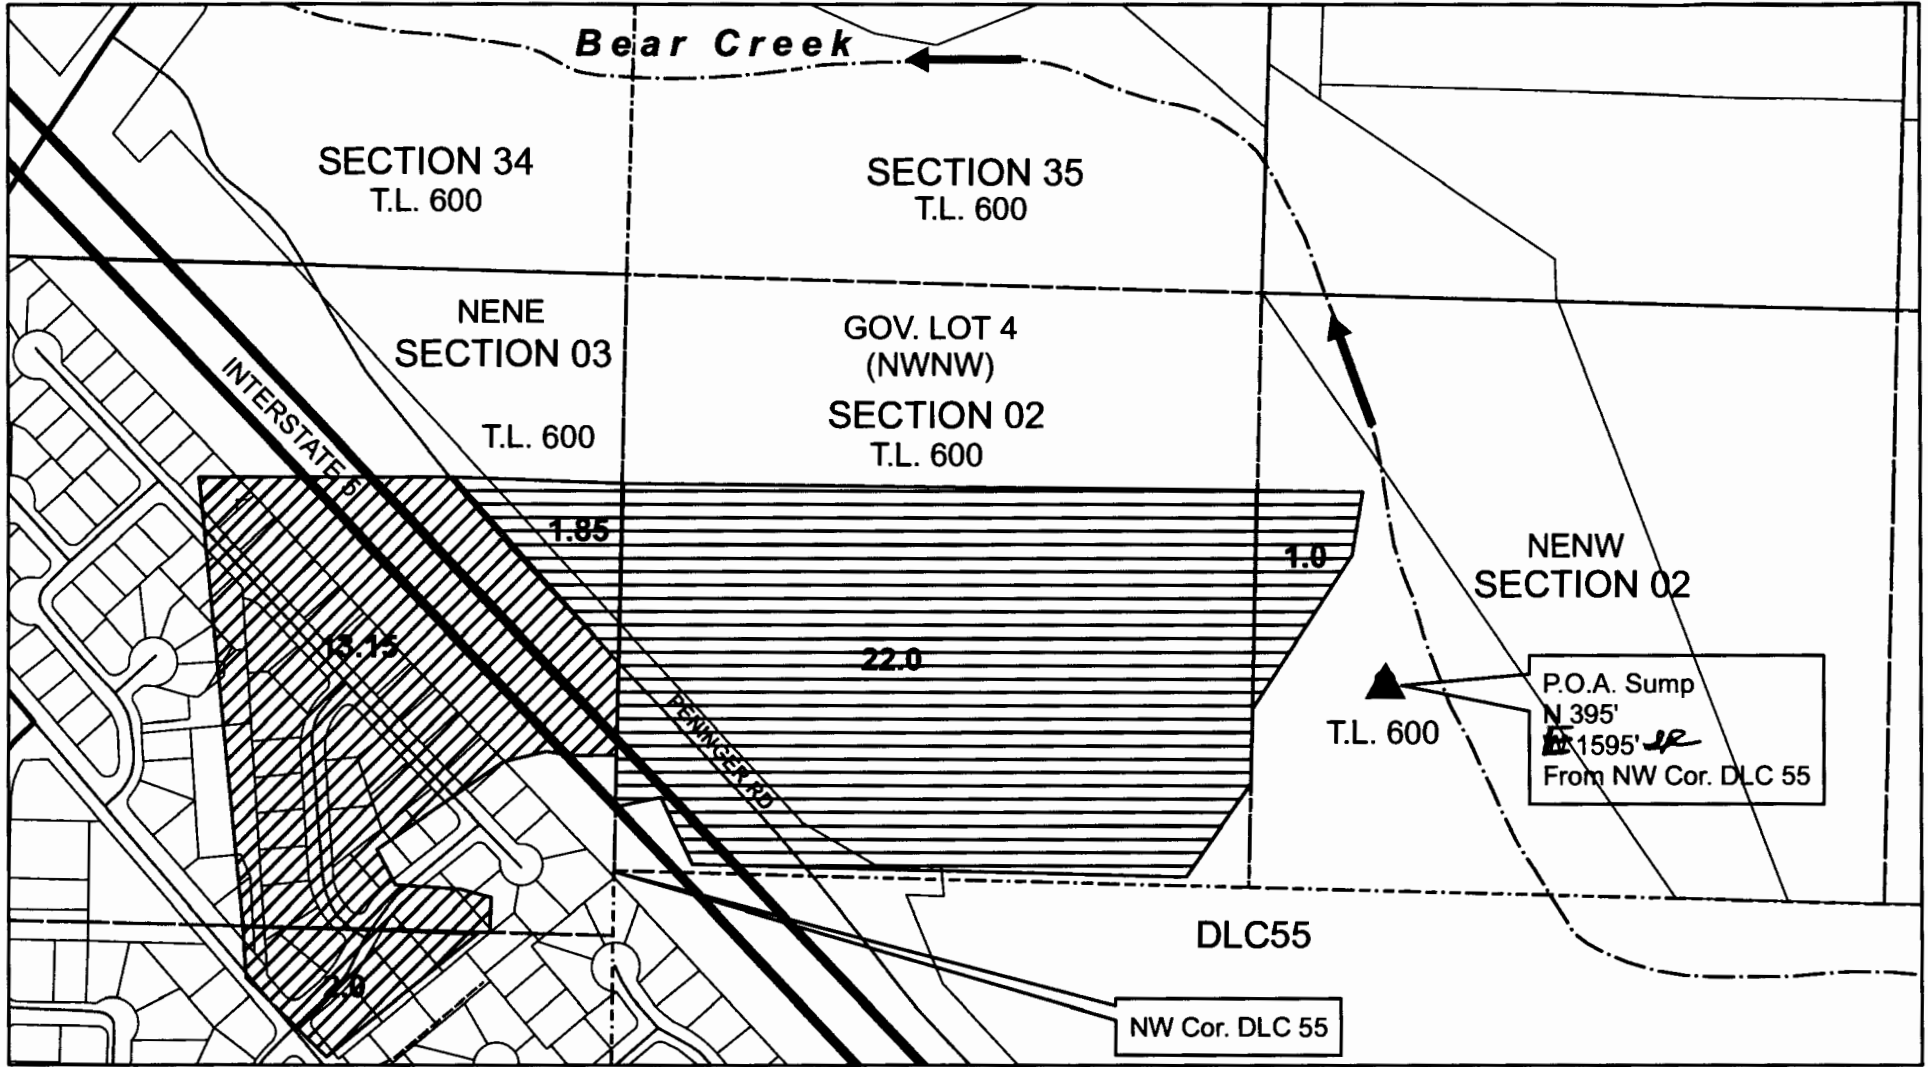


Map for water right purposes only; not for property boundary location.



1 in = 400 ft

### Legend

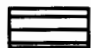 P.O.U. Change & Character of Use Change; Priority Date April 1949

 GR 756- No Change; Priority Date April 1949

P.O.A. No Change

RECEIVED BY OWRD

NOV 05 2015

SALEM, OR

T 12197

# Groundwater Registration Modification Map

## GR-756 Proposed Place of Use

### All Quarter-Quarter's in Jackson County

T29S R05W	T29S R04W	T29S R03W	T29S R02W	T29S R01W	T29S R01E	T29S R02E	T29S R03E	T29S R04E	T29S R05E
T30S R05W	T30S R04W	T30S R03W	T30S R02W	T30S R01W	T30S R01E	T30S R02E	T30S R03E	T30S R04E	T30S R05E
T31S R05W	T31S R04W	T31S R03W	T31S R02W	T31S R01W	T31S R01E	T31S R02E	T31S R03E	T31S R04E	T31S R05E
T32S R05W	T32S R04W	T32S R03W	T32S R02W	T32S R01W	T32S R01E	T32S R02E	T32S R03E	T32S R04E	T32S R05E
T33S R05W	T33S R04W	T33S R03W	T33S R02W	T33S R01W	T33S R01E	T33S R02E	T33S R03E	T33S R04E	T33S R05E
T34S R05W	T34S R04W	T34S R03W	T34S R02W	T34S R01W	T34S R01E	T34S R02E	T34S R03E	T34S R04E	T34S R05E
T35S R05W	T35S R04W	T35S R03W	T35S R02W	T35S R01W	T35S R01E	T35S R02E	T35S R03E	T35S R04E	T35S R05E
T36S R05W	T36S R04W	T36S R03W	T36S R02W	T36S R01W	T36S R01E	T36S R02E	T36S R03E	T36S R04E	T36S R05E
T37S R05W	T37S R04W	T37S R03W	T37S R02W	T37S R01W	T37S R01E	T37S R02E	T37S R03E	T37S R04E	T37S R05E
T38S R05W	T38S R04W	T38S R03W	T38S R02W	T38S R01W	T38S R01E	T38S R02E	T38S R03E	T38S R04E	T38S R05E
T39S R05W	T39S R04W	T39S R03W	T39S R02W	T39S R01W	T39S R01E	T39S R02E	T39S R03E	T39S R04E	T39S R05E
T40S R05W	T40S R04W	T40S R03W	T40S R02W	T40S R01W	T40S R01E	T40S R02E	T40S R03E	T40S R04E	T40S R05E
T41S R05W	T41S R04W	T41S R03W	T41S R02W	T41S R01W	T41S R01E	T41S R02E	T41S R03E	T41S R04E	T41S R05E

Map for water right purposes only; not for property boundary location.



1 in = 60,000 ft

1 12197

#### Legend

GR-756 Character and Place of Use Change; Priority Date April 1949