


North

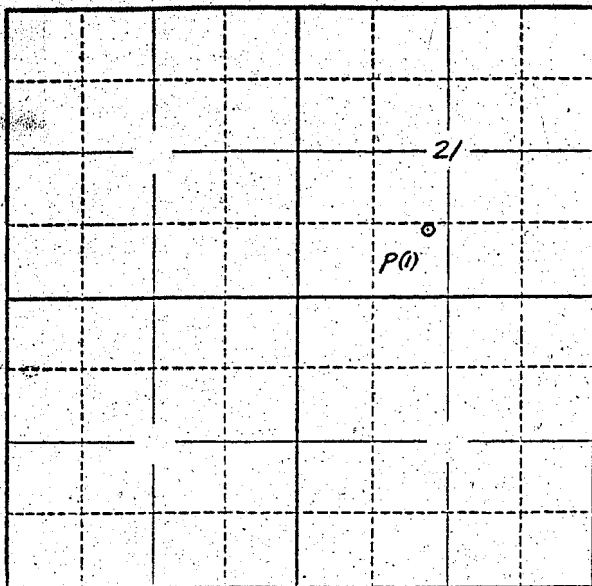

Locate well and acreage of irrigated land on plat.

Scale: 2" = 1 Mile

STATE OF OREGON

County of Washington } ss.

I, Serthy Lore, being first duly sworn, do hereby certify that I have read the foregoing Registration Statement and that all of the items therein contained are true to the best of my knowledge and belief.

Serthy Lore  
(Signature of Registrant)

Subscribed and sworn to before me this 29<sup>th</sup> day of Nov, 1957

MY COMMISSION EXPIRES MARCH 21, 1959

E. Pinkitt  
(Notary Public)

(SEAL)

**CERTIFICATE OF REGISTRATION**

STATE OF OREGON } ss.  
County of Marion

This is to certify that the foregoing Registration Statement was received in the office of the State Engineer on the 5<sup>th</sup> day of December, 1957, at 5:00 o'clock A.M. and has been duly recorded in said office in Book No. 4 of Registration Statements on page GR-738 C

Witness my hand this 24<sup>th</sup> day of January, 1958

Leura A. Stanley  
(State Engineer)

By \_\_\_\_\_ (Deputy)