


North

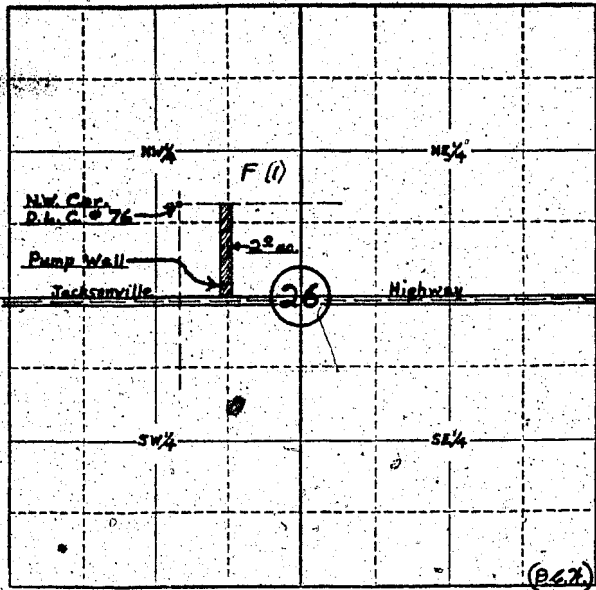

Locate well and acreage of irrigated land on plat.

Scale: **4'** = 1 Mile

STATE OF OREGON

County of Jackson

} ss.

I Thomas Grant being first duly sworn, do hereby certify that I have read the foregoing Registration Statement and that all of the items therein contained are true to the best of my knowledge and belief.

Thomas Grant  
Francis Grant  
(Signature of Registrant)

Subscribed and sworn to before me this 4 day of December, 1957

My commission expires Feb 1 1960

(Notary Public)

(SEAL)

**CERTIFICATE OF REGISTRATION**

STATE OF OREGON

County of Marion

} ss.

This is to certify that the foregoing Registration Statement was received in the office of the State Engineer on the 6<sup>th</sup> day of December, 1957, at 1.00 o'clock PM and has been duly recorded in said office in Book No. 4 of Registration Statements on page GR-743 C.

Witness my hand this 21<sup>st</sup> day of January, 1958

Lewis A. Stanley  
(State Engineer)

By \_\_\_\_\_ (Deputy)