


North

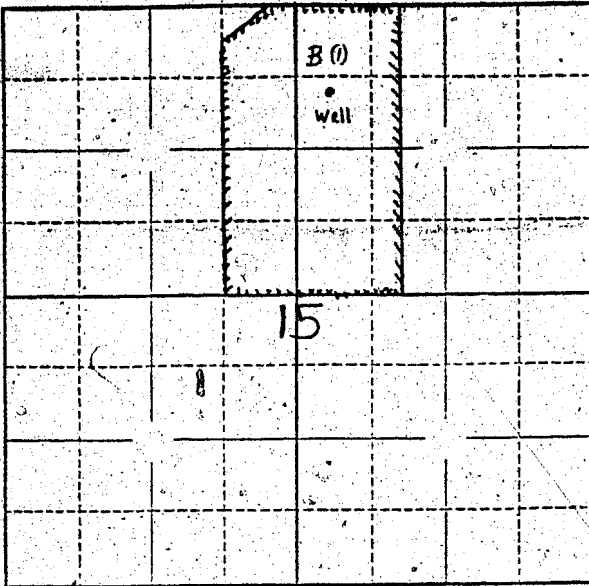

Locate well and acreage of irrigated land on plat.

Scale:  $\frac{2}{4}$  = 1 Mile

STATE OF OREGON

County of Marion } ss.

I, \_\_\_\_\_, being first duly sworn, do hereby certify that I have read the foregoing Registration Statement and that all of the items therein contained are true to the best of my knowledge and belief.

*Butch ...*  
(Signature of Registrant)

Subscribed and sworn to before me this 10th day of December, 19 57.

My commission expires June 12th, 1961 Wm. S. Bartholomew  
(Notary Public)

(SEAL)

**CERTIFICATE OF REGISTRATION**

STATE OF OREGON }  
County of Marion } ss.

This is to certify that the foregoing Registration Statement was received in the office of the State Engineer on the 10th day of December, 19 57 at 1:30 o'clock P. M. and has been duly recorded in said office in Book No. 4 of Registration Statements on page BR-746 C

Witness my hand this 24th day of January, 19 58

*Laura A. Stanley*  
(State Engineer)

By \_\_\_\_\_  
(Deputy)