


Township 16 S Range 3 W W.M.
North

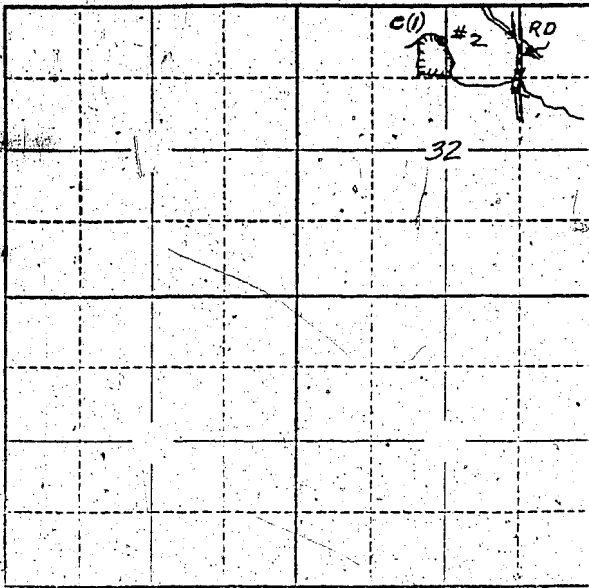

Locate well and acreage of irrigated land on plat.
Scale: 2" = 1 Mile

STATE OF OREGON
County of Lane } ss.

I, John Nelson Whitaker, being first duly sworn, do hereby certify that I have read the foregoing Registration Statement and that all of the items therein contained are true to the best of my knowledge and belief.

John Nelson Whitaker
(Signature of Registrant)

Subscribed and sworn to before me this 11th day of December, 1937.

My commission expires Sept 8, 1940
Cliff T. White
(Notary Public)

(SEAL)

CERTIFICATE OF REGISTRATION

STATE OF OREGON }
County of Marion } ss.

This is to certify that the foregoing Registration Statement was received in the office of the State Engineer on the 11th day of December, 1937 at 8:00 o'clock A.M. and has been duly recorded in said office in Book No. 1 of Registration Statements on page 100-200.

~~XX Construction shall be completed by 1938 and the water completely applied to beneficial use by 1938.~~

Witness my hand this 31st day of January, 1938.

Lewis A. Stanley
(State Engineer)

By _____
(Deputy)