


North

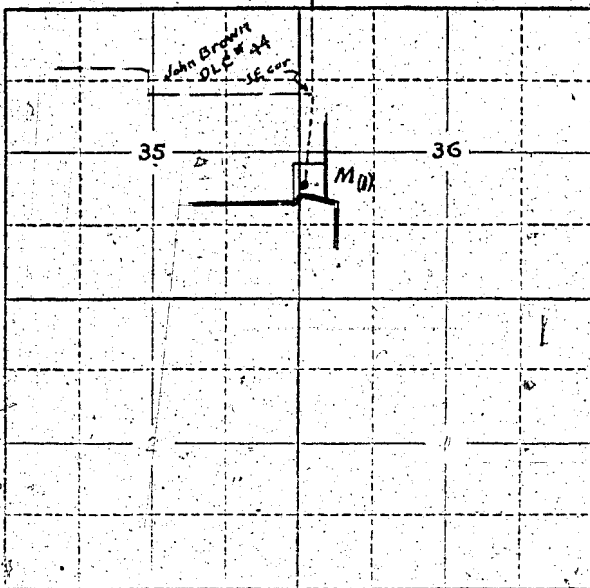

Locate well and acreage of irrigated land on plat.

Scale: 2" = 1 Mile

STATE OF OREGON

County of Lane

ss.

I, Alfred W. Jones, being first duly sworn, do hereby certify that I have read the foregoing Registration Statement and that all of the items therein contained are true to the best of my knowledge and belief.

Alfred W. Jones
Alfred W. Jones
(Signature of Registrant)

Subscribed and sworn to before me this 10th day of December, 1957.

My commission expires June 23, 1961

Ernest J. [unclear]
(Notary Public)

(SEAL)

CERTIFICATE OF REGISTRATION

STATE OF OREGON

County of Marion

ss.

This is to certify that the foregoing Registration Statement was received in the office of the State Engineer on the 12th day of December, 1957, at 5:00 o'clock A.M. and has been duly recorded in said office in Book No. 4 of Registration Statements on page GR-758C

~~Construction of the above described project is hereby approved, and the water completely approved~~

Witness my hand this 4th day of February, 1958

Lewis A. [unclear]
(State Engineer)

By _____ (Deputy)

GR-758C