


GR 79

T 105 R2W

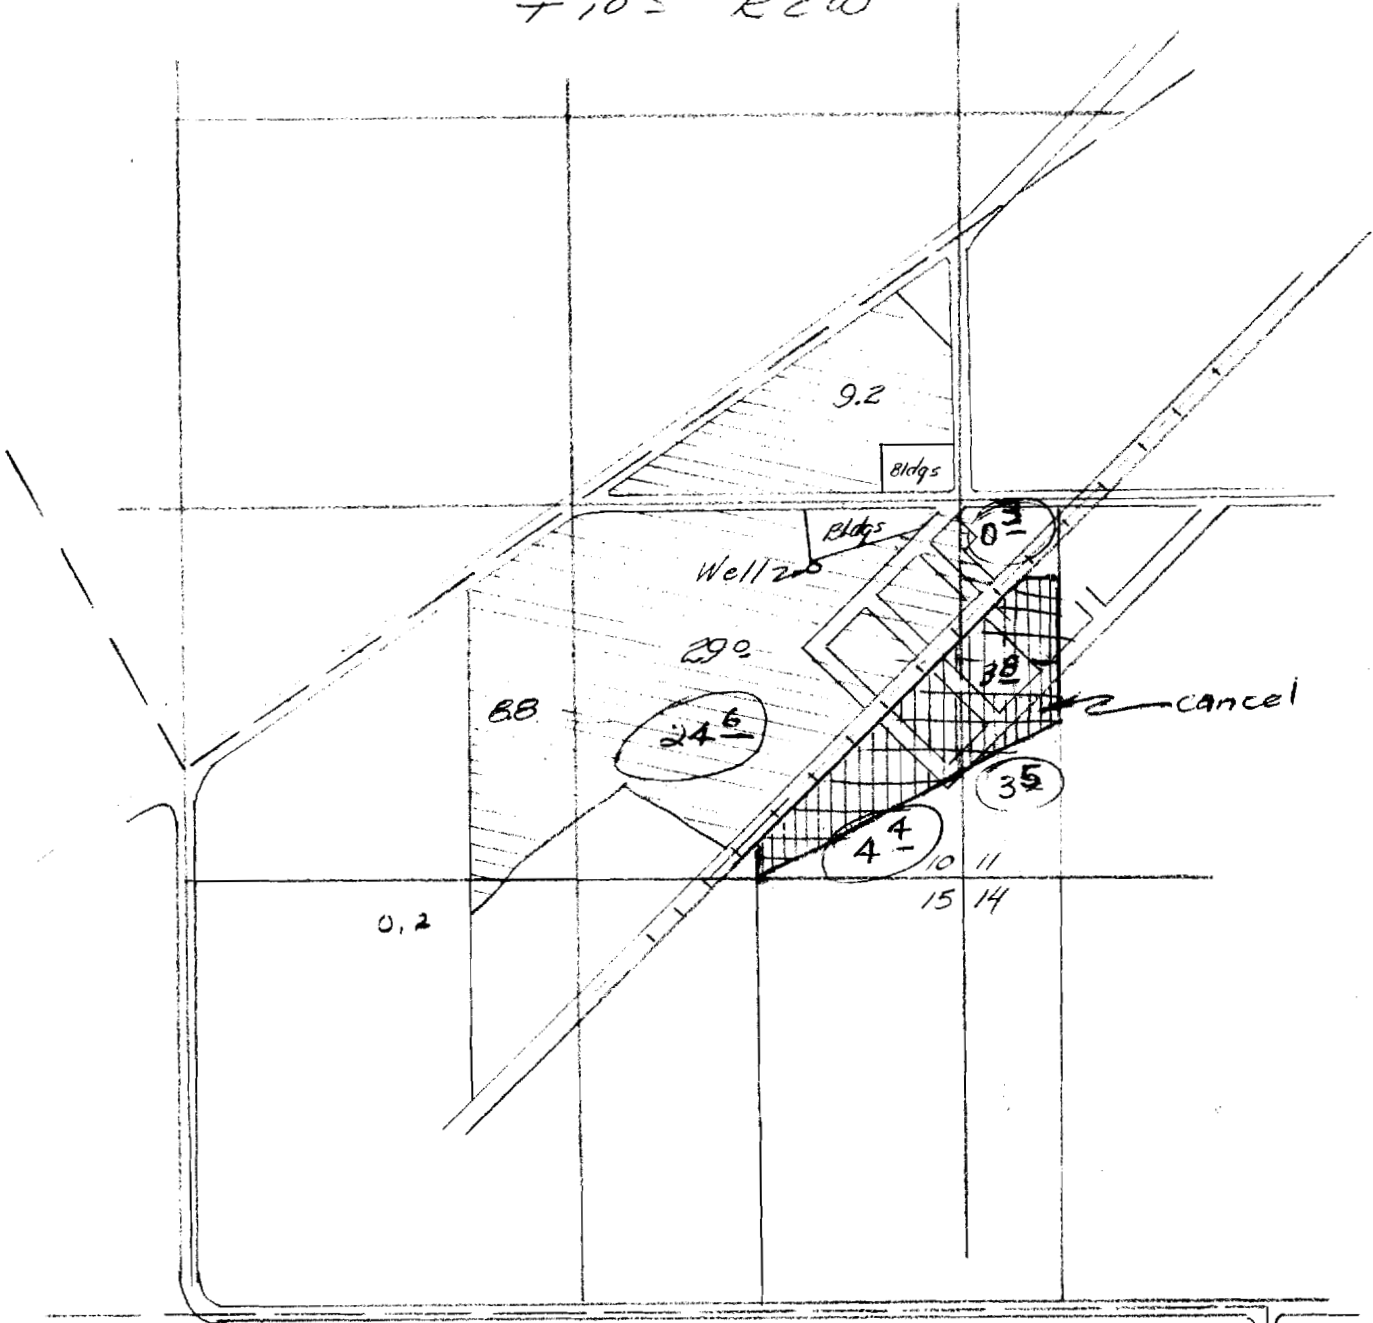

	29.8	162.2
192 gpm	x	x
<hr/>	<hr/>	<hr/>
51	7.9	43.1