


Township ³⁵ 4 S Range ^{1E} 1 E, W.M.
North

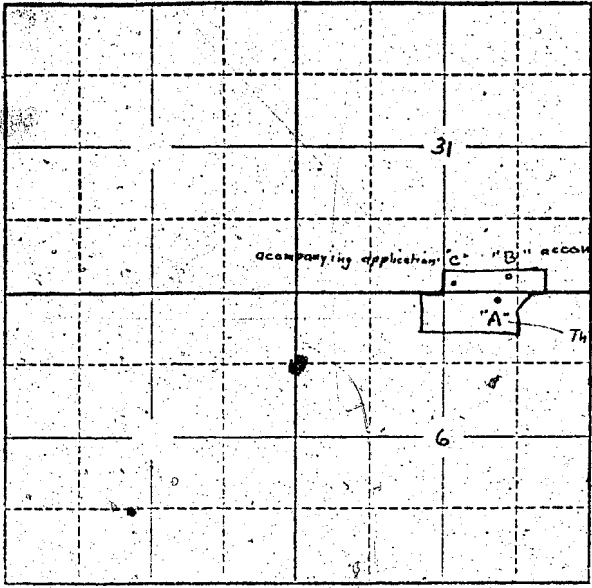

Locate well and acreage of irrigated land on plat.
Scale: 2" = 1 Mile

STATE OF OREGON
County of Multnomah } ss.

I, L. B. Cowgill, being first duly sworn, do hereby certify that I have read the foregoing Registration Statement and that all of the items therein contained are true to the best of my knowledge and belief.

Lester B. Cowgill
(Signature of Registrant)

Subscribed and sworn to before me this 27th day of December, 1957.

My commission expires June 20, 1961.
Foster Duck
(Notary Public)

(SEAL)

CERTIFICATE OF REGISTRATION

STATE OF OREGON } ss.
County of Marion

This is to certify that the foregoing Registration Statement was received in the office of the State Engineer on the 18 day of December, 1957, at 8:00 o'clock A. M. and has been duly recorded in said office in Book No. 4 of Registration Statements on page GR-773 C

~~Construction shall be completed by _____ day of _____, 19____ and the same shall be completed for beneficial use by _____ day of _____, 19____.~~

Witness my hand this 4th day of February, 1958

Laura A. Stanley
(State Engineer)

By _____
(Deputy)

GR-773 C

1500