


Township 17 Range 4 W.M.
North

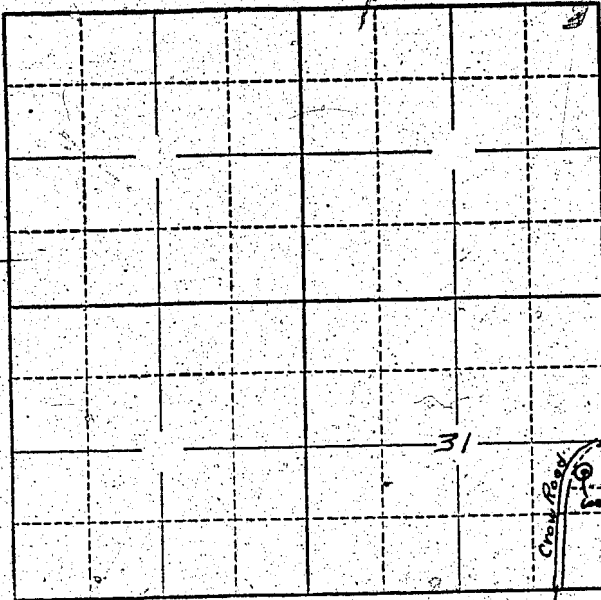

Locate well and acreage of irrigated land on plat
Scale: 2" = 1 Mile

STATE OF OREGON

County of Jane } ss.

I, HARRY BOWER, being first duly sworn, do hereby certify that I have read the foregoing Registration Statement and that all of the items therein contained are true to the best of my knowledge and belief.

Harry Bower
(Signature of Registrant)

Subscribed and sworn to before me this 7th day of Sept, 1955

My commission expires April 20, 1957

Ray Bowering
(Notary Public)

(SEAL)

CERTIFICATE OF REGISTRATION

STATE OF OREGON

County of Marion } ss.

This is to certify that the foregoing Registration Statement was received in the office of the State Engineer on the 8 day of September, 1955, at 8:00 o'clock A.M. and has been duly recorded in said office in Book No. 1 of Registration Statements on page 7

Construction shall be completed by _____, 19____, and the water is completely applied to beneficial use by _____, 19____.

Witness my hand this 24th day of February, 1956
Levo A. Stanley
(State Engineer)

By _____ (Deputy)