


North

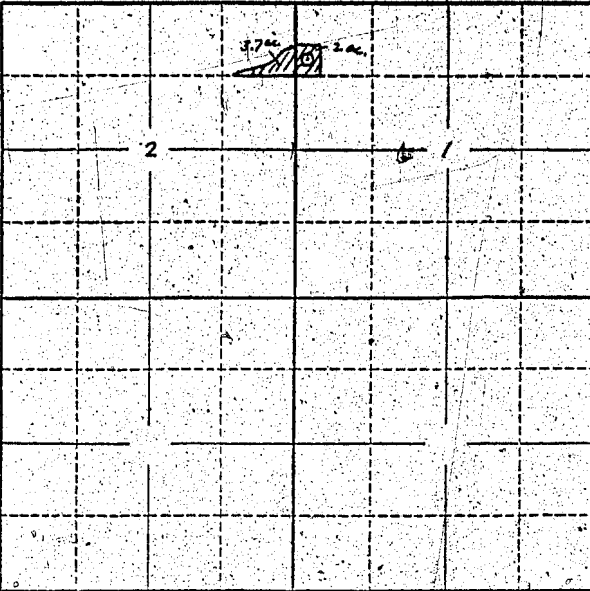

Locate well and acreage of irrigated land on plat.

Scale: 2" = 1 Mile

STATE OF OREGON

County of Linn } ss.

I, Vernon H. and Lena M. Woods, being first duly sworn, do hereby certify that I have read the foregoing Registration Statement and that all of the items therein contained are true to the best of my knowledge and belief.

Vernon H. Woods  
Lena M. Woods  
(Signatures of Registrant)

Subscribed and sworn to before me this 7th day of January, 19 56

My commission expires August 13, 1958 Wm. S. Grindle  
(Notary Public)

(SEAL)

**CERTIFICATE OF REGISTRATION**

STATE OF OREGON

County of Marion } ss. See Page GR-68 G for Certificate of Registration

This is to certify that the foregoing Registration Statement was received in the office of the State Engineer on the 13th day of January, 1956, at 8:00 o'clock A.M. and has been duly recorded in said office in Book No. 1 of Registration Statements on page 68

Construction shall <sup>is</sup> be completed by \_\_\_\_\_, 19\_\_\_\_, and the water <sup>is</sup> completely applied to beneficial use by \_\_\_\_\_, 19\_\_\_\_.

Witness my hand this 24th day of February, 1956.  
Lewis A. Stanley  
(State Engineer)

By \_\_\_\_\_ (Deputy)