


Township 9S Range 4W, W.M.  
North

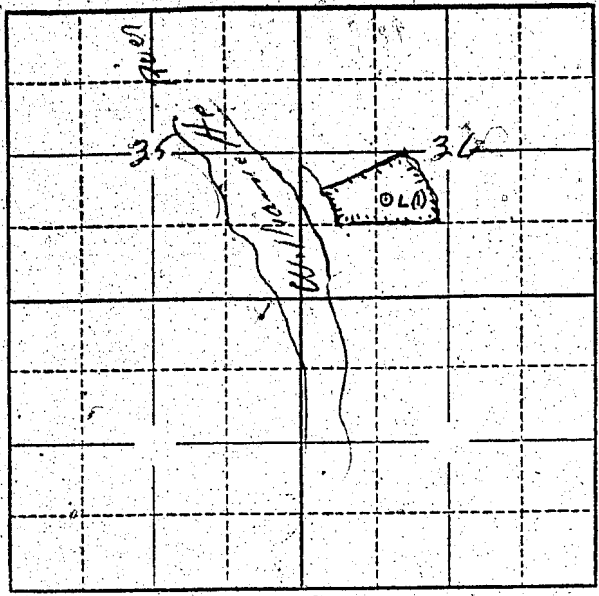

Locate well and acreage of irrigated land on plat.  
Scale: 2" = 1 Mile

STATE OF OREGON }  
County of Marion } ss.

I, \_\_\_\_\_, being first duly sworn, do hereby certify that I have read the foregoing Registration Statement and that all of the items therein contained are true to the best of my knowledge and belief.

Ray T. [Signature]  
(Signature of Registrant)

Subscribed and sworn to before me this 18th day of December, 1957.

My commission expires June 12th, 1961.  
Wm. S. Bartholomew  
(Notary Public)

(SEAL)

**CERTIFICATE OF REGISTRATION**

STATE OF OREGON }  
County of Marion } ss.

This is to certify that the foregoing Registration Statement was received in the office of the State Engineer on the 18 day of December, 1957, at 10:30 o'clock A. M. and has been duly recorded in said office in Book No. 4 of Registration Statements on page 777.

Witness my hand this 21 day of February, 1958.  
Lewis A. Stanley  
(State Engineer)

By \_\_\_\_\_  
(Deputy)