


North

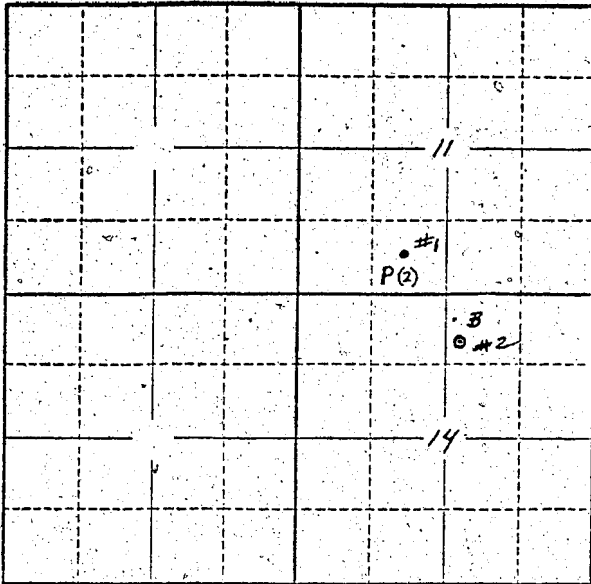

Locate well and acreage of irrigated land on plat.

Scale: 2" = 1 Mile

STATE OF OREGON

County of Linn } ss.

I, Mary Ammon, being first duly sworn, do hereby certify that I have read the foregoing Registration Statement and that all of the items therein contained are true to the best of my knowledge and belief.

Mary Ammon
(Signature of Registrant)

Subscribed and sworn to before me this 24th day of December, 1957

My commission expires MY COMMISSION EXPIRES FEB. 18, 1958
Jerry Caushie
(Notary Public)

(SEAL)

CERTIFICATE OF REGISTRATION

STATE OF OREGON }
County of Marion } ss.

This is to certify that the foregoing Registration Statement was received in the office of the State Engineer on the 24th day of December, 1957, at o'clock M. and has been duly recorded in said office in Book No. 4 of Registration Statements on page 801

Witness my hand this 21 day of February, 1958
Lewis A. Stanley
(State Engineer)

By
(Deputy)