


North

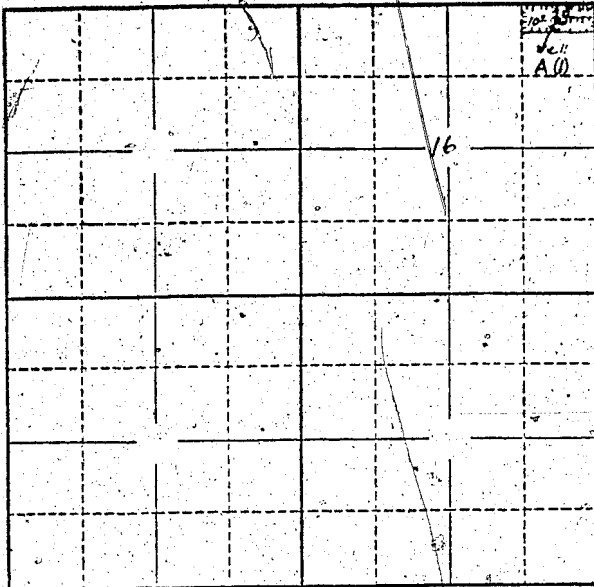

Locate well and acreage of irrigated land on plat.

Scale: 2" = 1 Mile

STATE OF OREGON

County of Tillamook

ss.

I, George Earl Milne, being first duly sworn, do hereby certify that I have read the foregoing Registration Statement and that all of the items therein contained are true to the best of my knowledge and belief.

George Earl Milne
(Signature of Registrant)

Subscribed and sworn to before me this 3rd day of December, 1957.

My commission expires 9-11-61

Edwin C. Kieckhefer
(Notary Public)

(SEAL)

CERTIFICATE OF REGISTRATION.

STATE OF OREGON

County of Marion

ss.

This is to certify that the foregoing Registration Statement was received in the office of the State Engineer on the 27th day of December, 1957, at 2:00 o'clock P.M. and has been duly recorded in said office in Book No. 4 of Registration Statements on page 804.

Witness my hand this 21 day of February, 1958.

Lewis A. Stanley
(State Engineer)

By _____ (Deputy)