


North

See Map Well No. I.

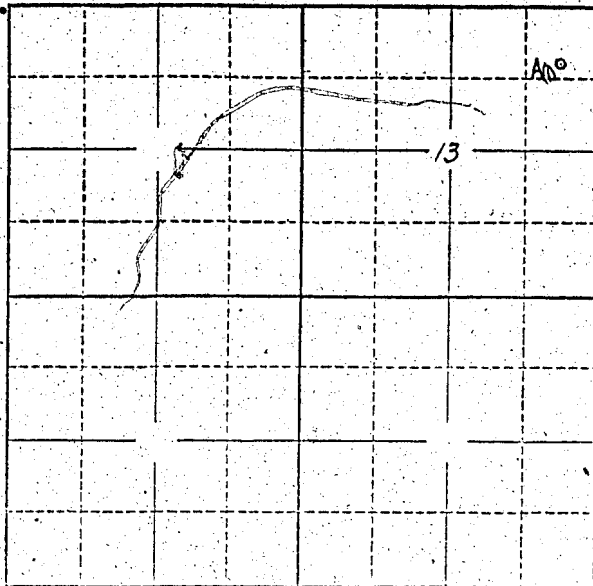

Locate well and acreage of irrigated land on plat.

Scale: 2" = 1 Mile

STATE OF OREGON

County of Lane

ss.

I, John C. Johnson, being first duly sworn, do hereby certify that I have read the foregoing Registration Statement and that all of the items therein contained are true to the best of my knowledge and belief.

John C. Johnson
(Signature of Registrant)

Subscribed and sworn to before me this 10 day of Feb, 1957

My commission expires Feb. 7, 1960

(Notary Public)

(SEAL)

CERTIFICATE OF REGISTRATION

STATE OF OREGON

County of Marion

ss.

This is to certify that the foregoing Registration Statement was received in the office of the State Engineer on the 30 day of December, 1957, at 8:00 o'clock A.M. and has been duly recorded in said office in Book No. 5 of Registration Statements on page 808

Construction shall be completed by XXXXXXXXXXXXXXXXXXXX and the water completely applied to beneficial use by XXXXXXXXXXXXXXXXXXXX

Witness my hand this 21 day of February, 1958

Lewis A. Stanley
(State Engineer)

By (Deputy)

15.00