


See Map Well No 3

North

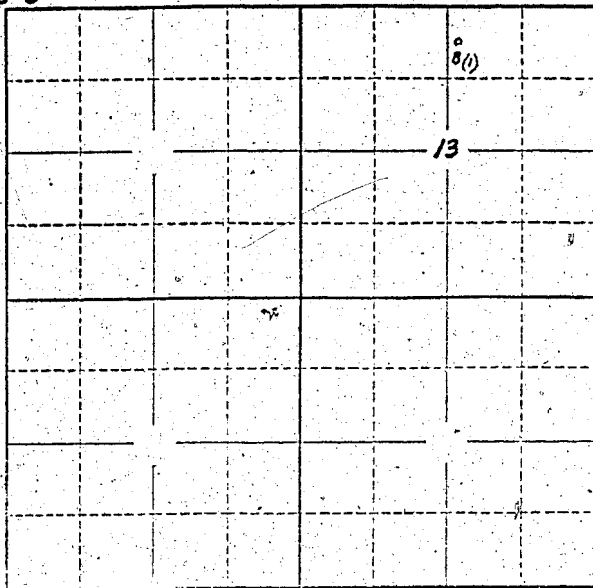

Locate well and acreage of irrigated land on plat.

Scale: 2" = 1 Mile

STATE OF OREGON

County of Lane

ss.

I, John C. Johnson, being first duly sworn, do hereby certify that I have read the foregoing Registration Statement and that all of the items therein contained are true to the best of my knowledge and belief.

*John C. Johnson*  
 (Signature of Registrant)

Subscribed and sworn to before me this \_\_\_\_\_ day of \_\_\_\_\_, 19\_\_\_\_

NOTARY PUBLIC FOR OREGON

My commission expires \_\_\_\_\_

(Notary Public)

(SEAL)

**CERTIFICATE OF REGISTRATION**

STATE OF OREGON

County of Marion

ss.

This is to certify that the foregoing Registration Statement was received in the office of the State Engineer on the 30 day of December, 1957, at 8:00 o'clock A.M. and has been duly recorded in said office in Book No. 5 of Registration Statements on page 810

~~Construction shall be completed by \_\_\_\_\_ and the water conserved applied to beneficial use by \_\_\_\_\_~~

Witness my hand this 21 day of February, 1958

*Lewis A. Stanley*  
 (State Engineer)

By \_\_\_\_\_

(Deputy)