


See Map Well No. 4.

North

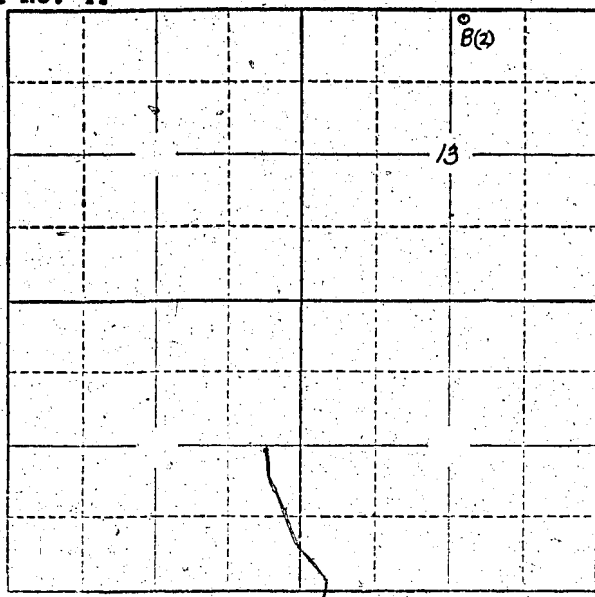

Locate well and acreage of irrigated land on plat.  
Scale: 2" = 1 Mile

STATE OF OREGON

County of Lane } ss.

I, John C. Johnson, being first duly sworn, do hereby certify that I have read the foregoing Registration Statement and that all of the items therein contained are true to the best of my knowledge and belief.

*John C. Johnson*  
(Signature of Registrant)

Subscribed and sworn to before me this \_\_\_\_\_ day of \_\_\_\_\_, 19\_\_\_\_

My commission expires \_\_\_\_\_  
NOTARY PUBLIC FOR OREGON

(Notary Public)

(SEAL)

**CERTIFICATE OF REGISTRATION**

STATE OF OREGON

County of Marion } ss.

This is to certify that the foregoing Registration Statement was received in the office of the State Engineer on the 30 day of December, 1957, at 8:00 o'clock A.M. and has been duly recorded in said office in Book No. 5 of Registration Statements on page 811

~~Construction shall be completed by xxxxxxxxxxxxxxxxxxxxxxxx 19\_\_\_\_ and the water conserved & applied to beneficial uses by xxxxxxxxxxxxxxxxxxxxxxxx 19\_\_\_\_~~

Witness my hand this 21 day of February, 1958

*Lewis A. Stanley*  
(State Engineer)

By \_\_\_\_\_  
(Deputy)