


North

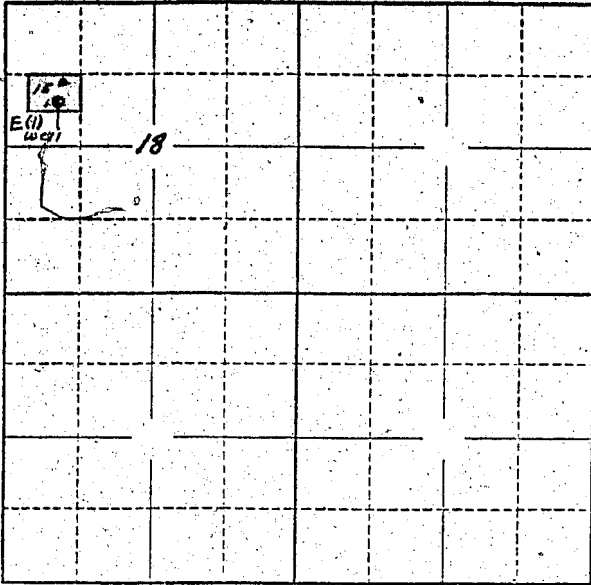

Locate well and acreage of irrigated land on plat.

Scale: 2" = 1 Mile

STATE OF OREGON

County of Marion ss.

I, Rudolph Zistel, being first duly sworn, do hereby certify that I have read the foregoing Registration Statement and that all of the items therein contained are true to the best of my knowledge and belief.

Rudolph Zistel  
(Signature of Registrant)

Subscribed and sworn to before me this 30<sup>th</sup> day of December, 1957

My commission expires Sept 8, 1960

Chas. H. Hahn  
(Notary Public)

(SEAL)

**CERTIFICATE OF REGISTRATION**

STATE OF OREGON }  
County of Marion } ss.

This is to certify that the foregoing Registration Statement was received in the office of the State Engineer on the 30 day of December, 1957, at 11:30 o'clock A. M. and has been duly recorded in said office in Book No. 5 of Registration Statements on page 813

Witness my hand this 21 day of February, 1958

Lewis A. Stanley  
(State Engineer)

By \_\_\_\_\_  
(Deputy)