


Township 7S Range 3W, W.M.
North

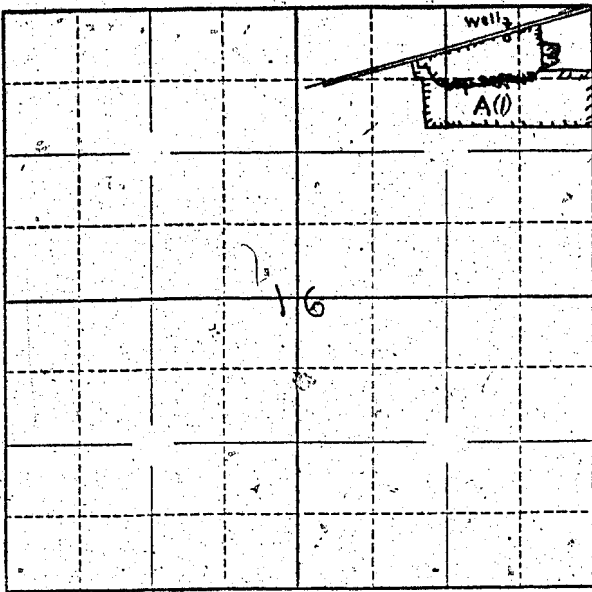

Locate well and acreage of irrigated land on plat.

Scale: ~~1/4~~ = 1 Mile

STATE OF OREGON

County of Marion } ss.

I, Vernon Lund being first duly sworn, do hereby certify that I have read the foregoing Registration Statement and that all of the items therein contained are true to the best of my knowledge and belief.

Vernon Lund
(Signature of Registrant)

Subscribed and sworn to before me this 30 day of December, 1957.

My commission expires 9/27/58

Jeanie Baxter
(Notary Public)

(SEAL)

CERTIFICATE OF REGISTRATION

STATE OF OREGON
County of Marion

This is to certify that the foregoing Registration Statement was received in the office of the State Engineer on the 30 day of December, 1958, at 8:00 o'clock A.M. and has been duly recorded in said office in Book No. 1500 of Registration Statements on page 814.

Witness my hand this 21 day of February, 1958.

Lewis C. Stanley
(State Engineer)

By _____
(Deputy)