


Township 15 S Range 4 W, W.M. North

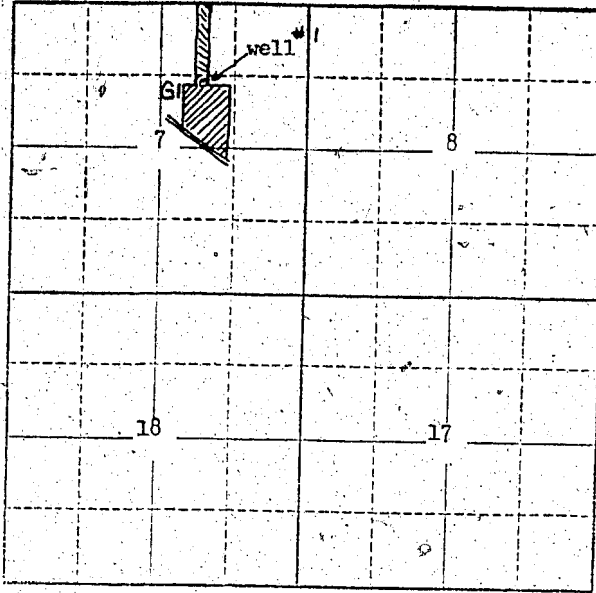

Locate well and acreage of irrigated land on plat. Scale: 2" = 1 Mile

STATE OF OREGON

County of Linn } ss.

I, Raymond W. Smith, being first duly sworn, do hereby certify that I have read the foregoing Registration Statement and that all of the items therein contained are true to the best of my knowledge and belief.

Raymond W. Smith (Signature of Registrant)

Subscribed and sworn to before me this 21st day of November, 1957

My commission expires Aug. 10, 1959

Ray Zehn (Notary Public)

(SEAL)

CERTIFICATE OF REGISTRATION

STATE OF OREGON } ss. County of Marion

This is to certify that the foregoing Registration Statement was received in the office of the State Engineer on the 30 day of December, 1957, at 8:00 o'clock A.M. and has been duly recorded in said office in Book No. 2 of Registration Statements on page 815

Construction shall be completed by 12/31/58 and the water completely applied to beneficial use by 12/31/59

Witness my hand this 21 day of February, 1958

Laura A. Stanley (State Engineer)

By (Deputy)

#157