


North

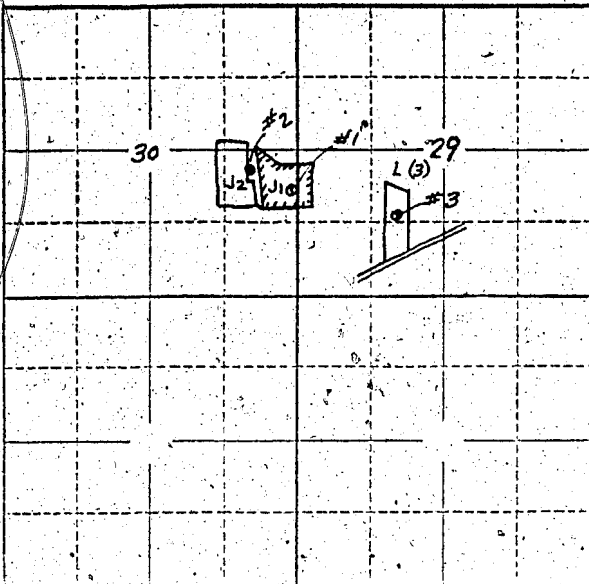

Locate well and acreage of irrigated land on plat.

Scale: 2" = 1 Mile

STATE OF OREGON

County of LINN

SS.

I, Harvey Freitag, being first duly sworn, do hereby certify that I have read the foregoing Registration Statement and that all of the items therein contained are true to the best of my knowledge and belief.

Subscribed and sworn to before me this 27th day of December, 1957

My commission expires May 11, 1960

(SEAL)

Harvey Freitag
 (Signature of Registrant)

Ronald S. Matthews
 (Notary Public)

CERTIFICATE OF REGISTRATION

STATE OF OREGON

County of Marion

SS.

This is to certify that the foregoing Registration Statement was received in the office of the State Engineer on the 3rd day of January, 1958, at 2:00 o'clock P.M. and has been duly recorded in said office in Book No. 2 of Registration Statements on page 820.

Construction shall be completed by XXXXXXXXXXXXXXXXXXXX 19 XXX and the water completely applied to beneficial use by XXXXXXXXXXXXXXXXXXXX 19 XXXXX

Witness my hand this 21 day of February, 1958

Lewis A. Stanley
 (State Engineer)

By

(Deputy)

15.00