


North

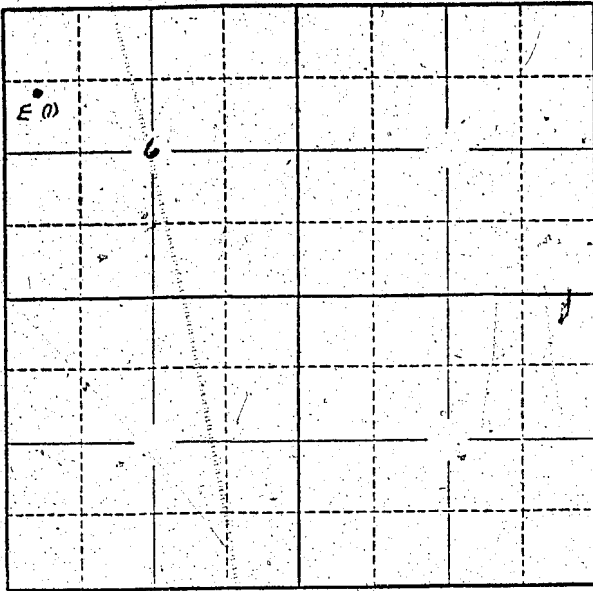

Locate well and acreage of irrigated land on plat.

Scale: 2" = 1 Mile

STATE OF OREGON

County of Linn Benton } SS.

I, Fred C. and Dora E. Myers, being first duly sworn, do hereby certify that I have read the foregoing Registration Statement and that all of the items therein contained are true to the best of my knowledge and belief.

Fred C. Myers
(Signature of Registrant)

Subscribed and sworn to before me this 30 day of March, 1958

My commission expires _____
Edward Stanley
(Notary Public)

(SEAL)

CERTIFICATE OF REGISTRATION

STATE OF OREGON }
County of Marion } SS.

This is to certify that the foregoing Registration Statement was received in the office of the State Engineer on the 30 day of March, 1958, at 5:00 o'clock A. M. and has been duly recorded in said office in Book No. 5 of Registration Statements on page 827.

Witness my hand this 5 day of March, 1958.
Lewis A. Stanley
(State Engineer)

By _____
(Deputy)